


T. 38 S., R. 5 W., W. M.

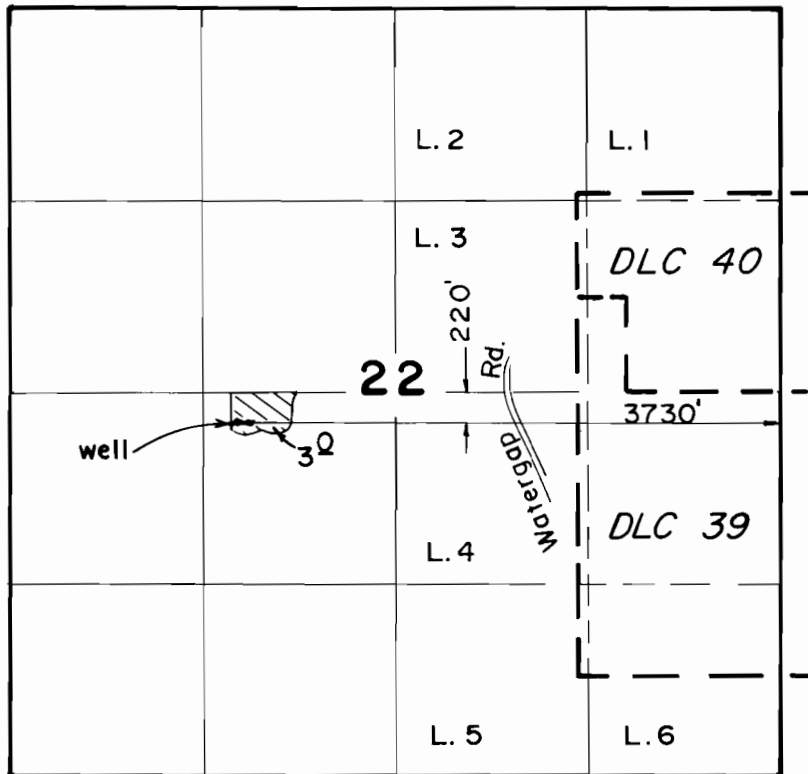

Scale: 1" = 1320'

FINAL PROOF SURVEY
UNDER

Application No. G-10561. Permit No. G-9700.....
IN NAME OF

FRANK N. & ANN ADELE GLEMBA

Surveyed AUG. 11. 1988., by B. S. JAMES...