


T. 38 S., R. 5 W., W. M.

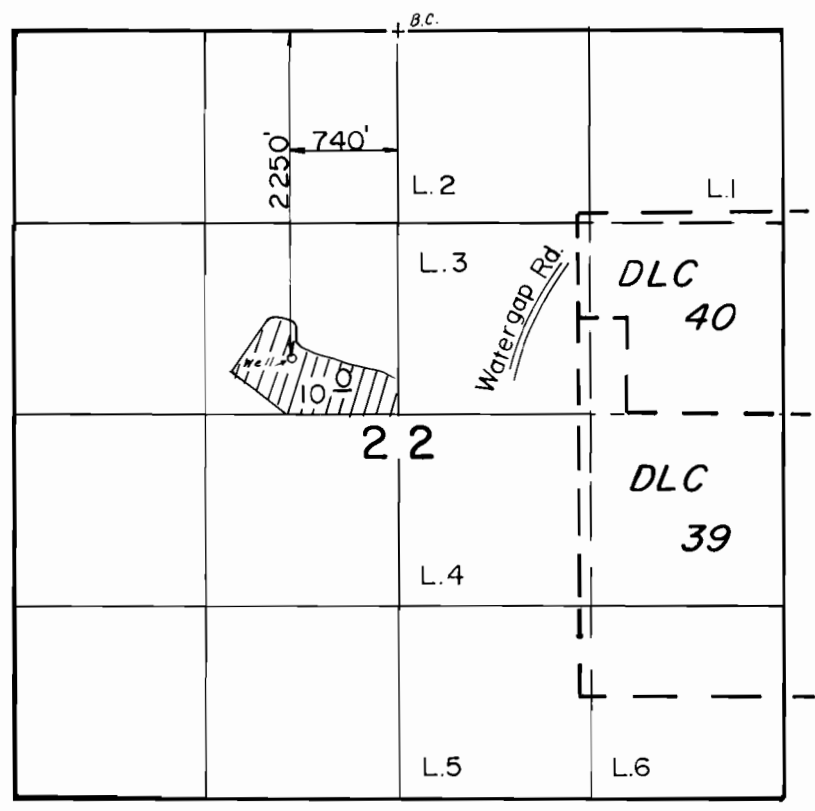

Scale: 1" = 1320'

FINAL PROOF SURVEY
UNDER

Application No. G-10606 Permit No. G-9724.
IN NAME OF

PERRY L. & ANN L. PETERSON

Surveyed AUG. 10. 19.88, by B. S. JAMES.....