


G-10167
66523

T. 13S., R. 31E., W.M.

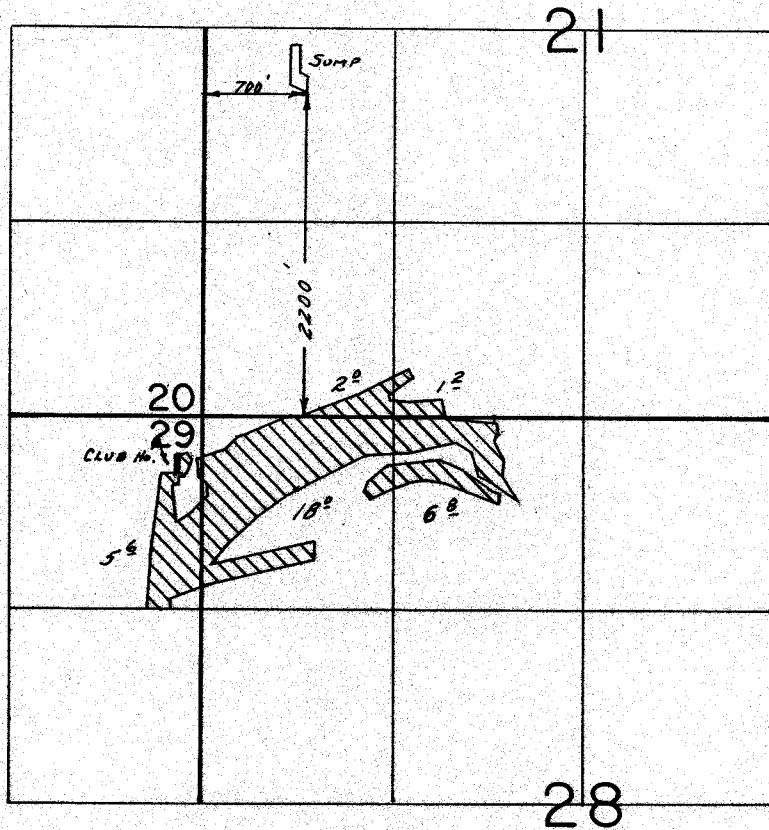

SCALE: 1" = 1320'

FINAL PROOF SURVEY
UNDER

Application No. G-10988 Permit No. G-10167....
IN NAME OF

MOUNTAIN VIEW COUNTRY CLUB

Surveyed June 16, 1988, by V.L. CHURCH....

4/17/89 gwb
41023-179-74 & PTS