


T. 30S., R. 2W., W.M.

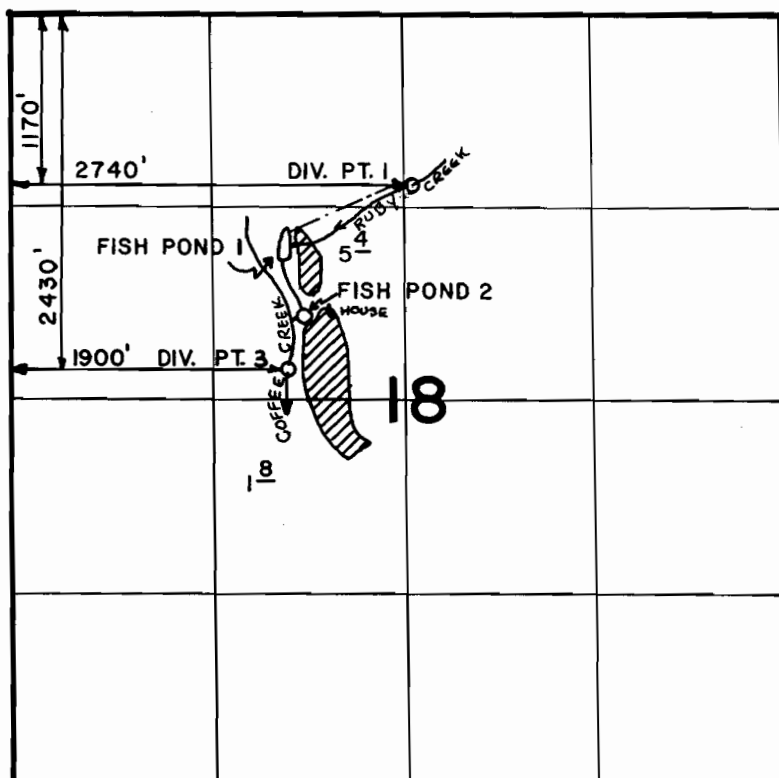

POND 2- 2100'S & 1950'E FROM NW COR. SEC. 18

SCALE: 4" = 1 MILE

FINAL PROOF SURVEY

UNDER

R- 50149 R- 6142
Application No. 50150 Permit No. 37953
IN NAME OF

CHARLIE DAVID GARREN

Surveyed JULY 30, 1987, by J.M. SCHMORDE.