
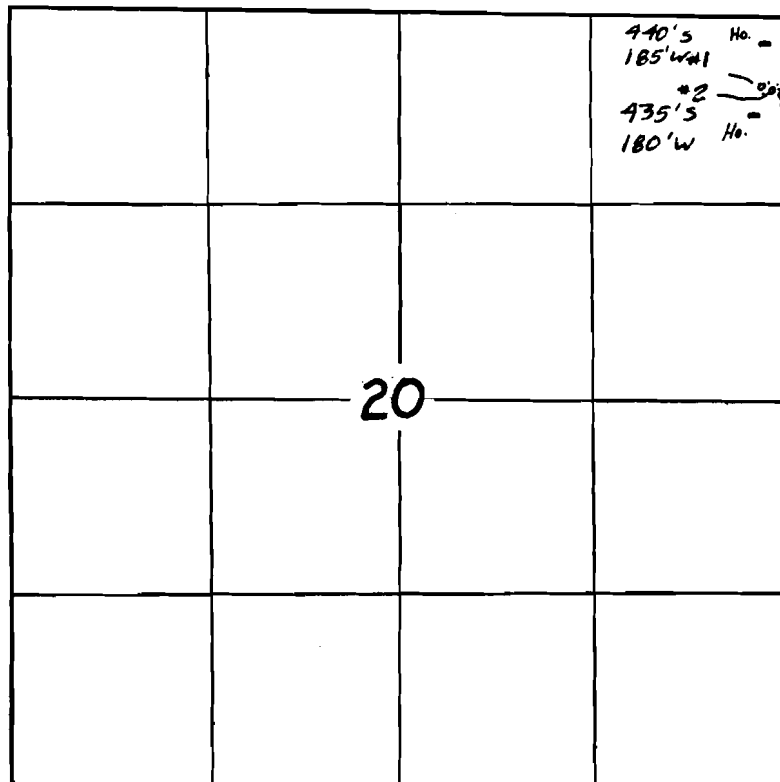


T. 17 S. R. 17 E. W. M.

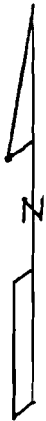

Scale 4" = 1 mile

Map to accompany application of water right for
William A. & Holly A. Armstrong

RECEIVED

SEP 23 1976

WATER RESOURCES DEPT
SALEM, OREGON

Application No. 54432
Permit No. 40819

RECEIVED

JUL 2 1976

WATER RESOURCES DEPT
SALEM, OREGON

Cert. # 66527
inspection: no F.P. map

Ⓟ # 40819