


42881  
66528

T. 35 S., R. 7 E., W.M.  
SECTION 6

AGENCY  
LAKE

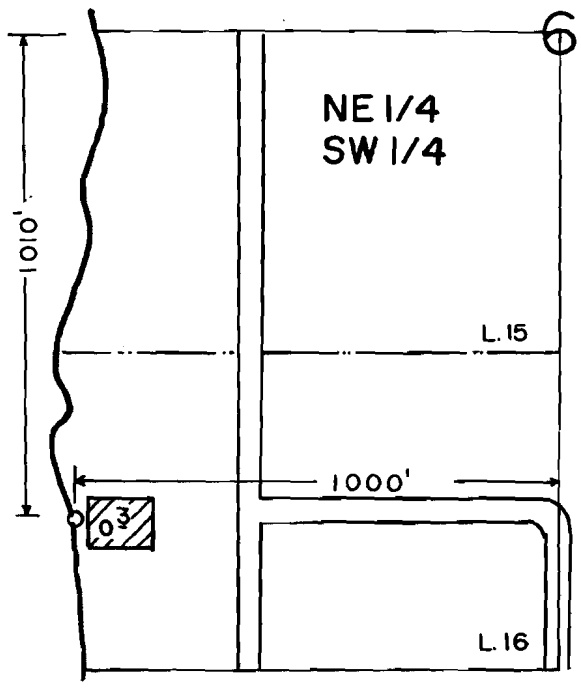

**FINAL PROOF SURVEY**  
UNDER

Application No. 56048. Permit No. 42881.....  
 IN NAME OF  
**DENVER S. AND/OR IRMA GARNER**  
 Surveyed MAY 26 1988., by B.W. BISHOP.....

*Agency Lake & more*