


T. 8 S., R. 38 E., W.M.

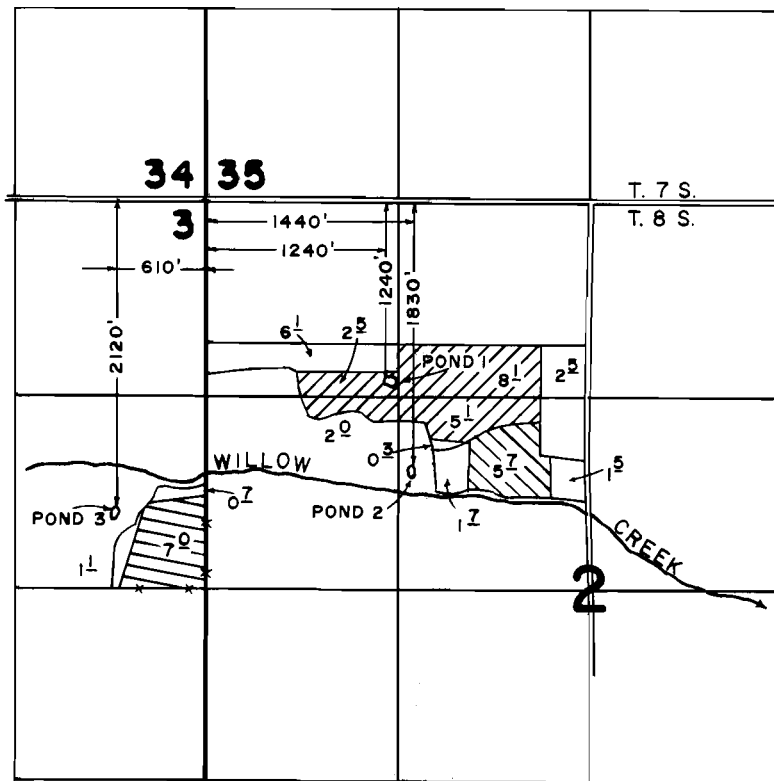

SCALE: 1" = 1320'

**FINAL PROOF SURVEY**  
UNDER

-  POND 1
-  POND 2
-  POND 3

Application No. 56084 Permit No. 42339....  
IN NAME OF

**FRED B. SCHREECK**

Surveyed APRIL 4 1990, by V. L. CHURCH.

6-20-90

41001-179-279 R