


T. 9 S., R. 45 E., W.M.

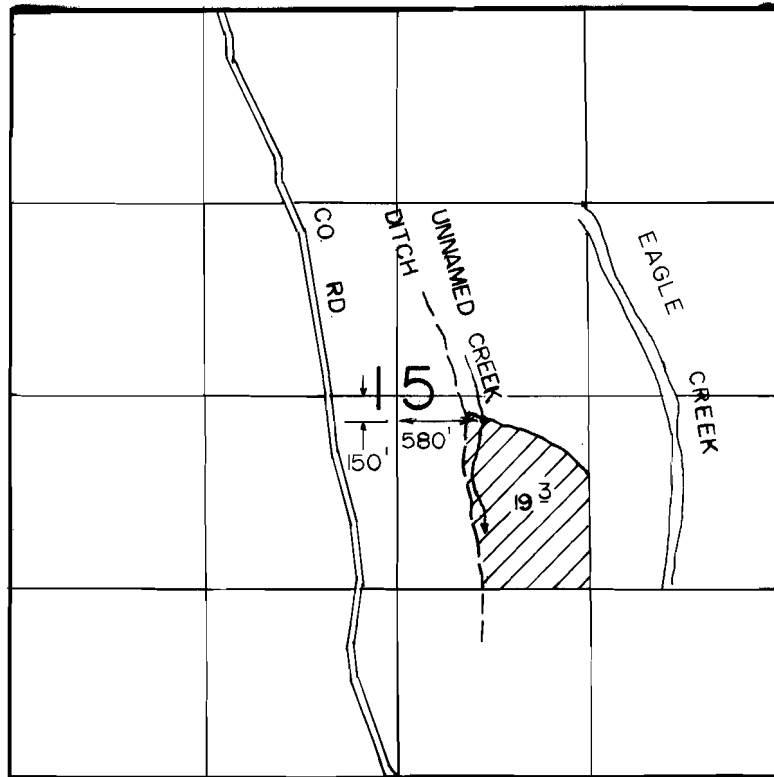

1" = 1320'

SUPPLEMENTAL IRRIGATION

**FINAL PROOF SURVEY  
UNDER**

Application No. 56426.. Permit No. 42336.....  
IN NAME OF

.....**JOHN A. CHANDLER**.....

Surveyed AUGUST 9 1990, by K. KEMP

2-5-91 DSM  
BBB-2KK-95