


T.IOS.,R.I W.,W.M.

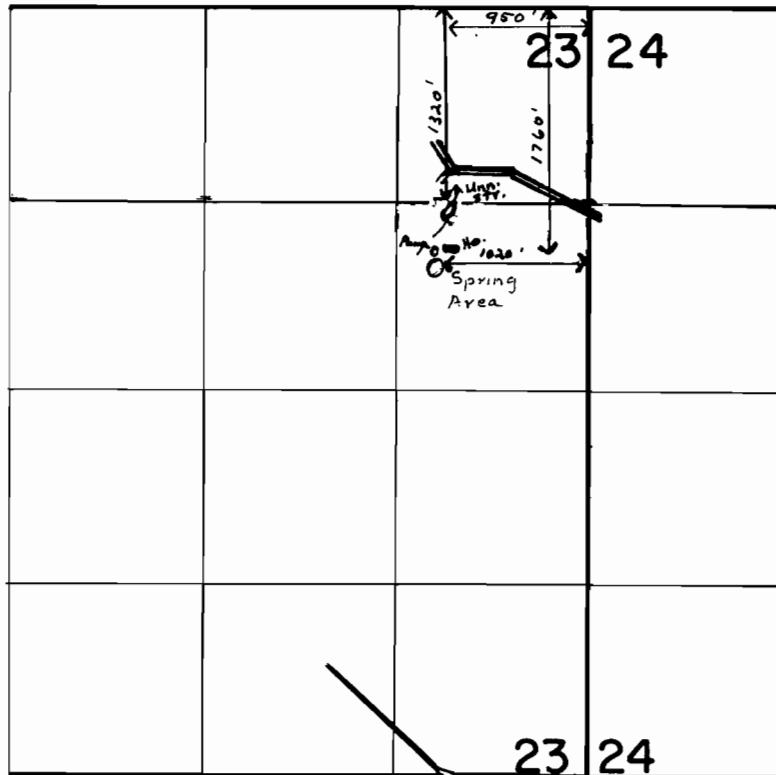

1" = 1320'

FINAL PROOF SURVEY
UNDER

R-67892

R-9311

67893

48219

Application No. 62600 Permit No. 46577.....

IN NAME OF

RICHARD SPENCER

Surveyed OCT. 13, 1983, by M. CAHILL.....

MAY 1 1984 L M TOLL