


T. 33 S., R. 1 W., W.M.

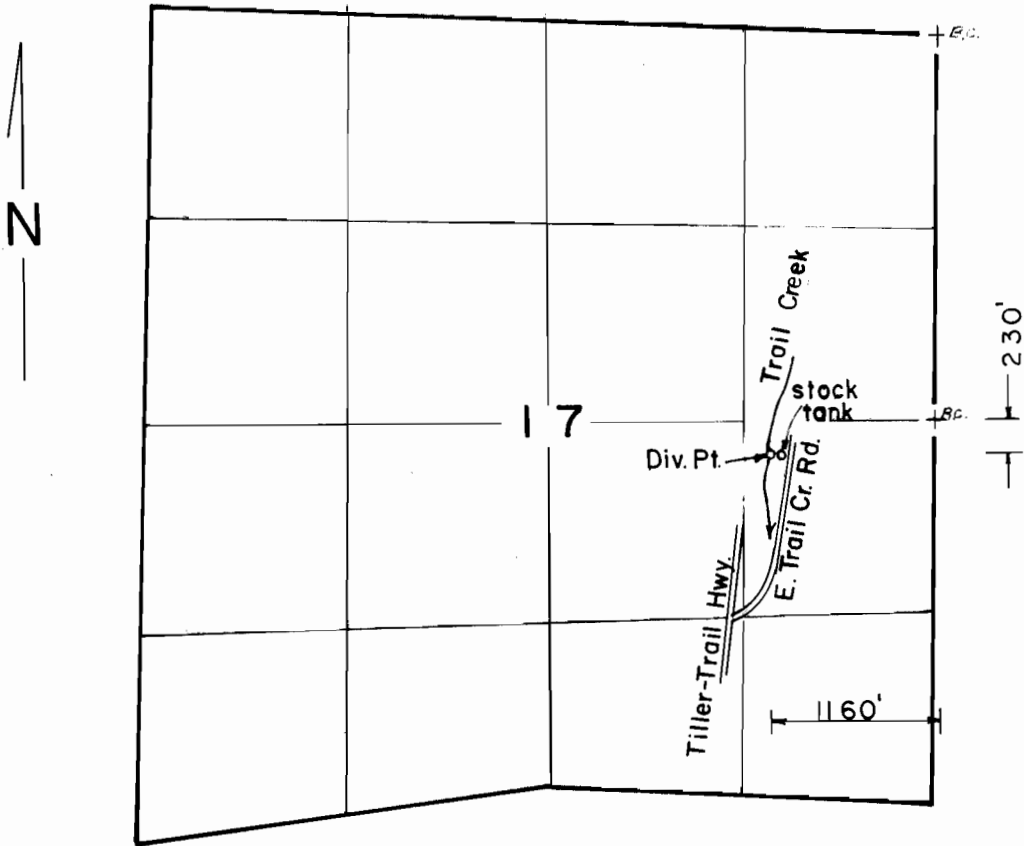

Scale: 1" = 1320"

FINAL PROOF SURVEY UNDER

Application No. 64594 Permit No. 47340
IN NAME OF

Surveyed MAY 17 1990, by B. S. JAMES