


T.19S., R.3W., W.M.

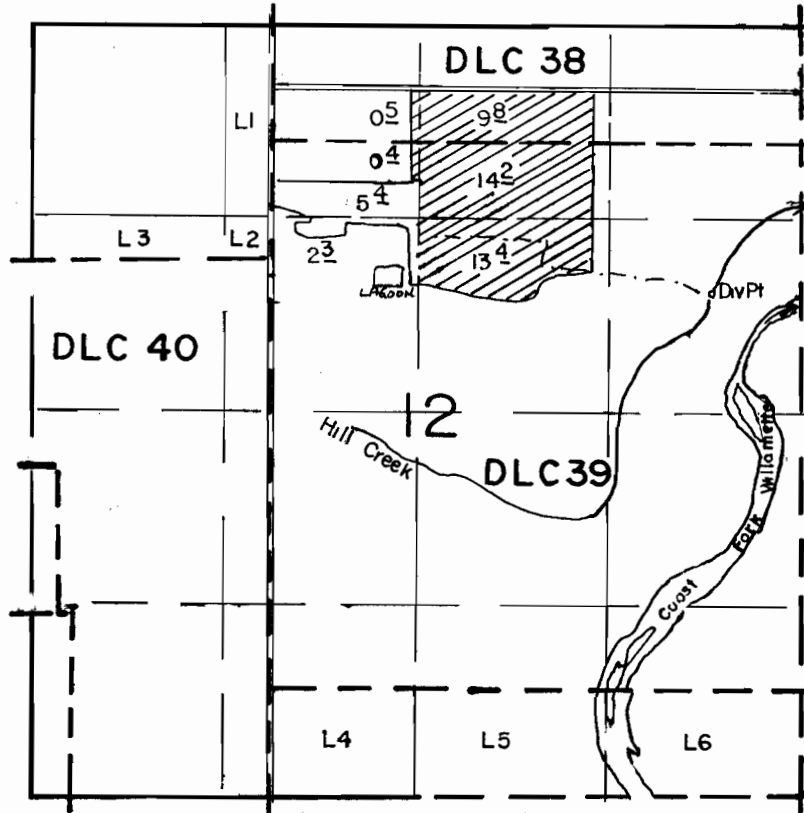

Div Pts Located - Creek 1850'S & 630'W, Lagoon 700'S & 2850'W Both From The NE Corner Of Section 12

SCALE: 1"=1320'

FINAL PROOF SURVEY UNDER

R-65488

R-9200

Application No. 66885... Permit No. 48107.....

IN NAME OF

.....ELDON..... HARROLD.....

Surveyed JUNE 4... 1990.. by J.M. WARREN...