


T.19S., R.3W., W.M.

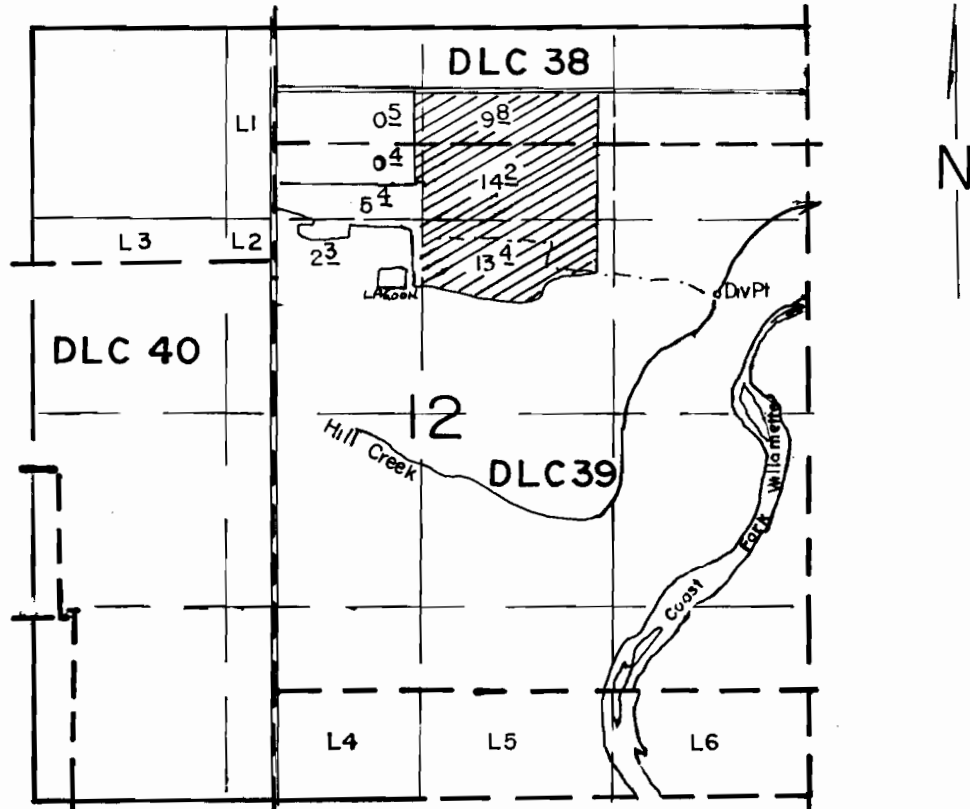

Div Pts Located - Creek 1850'S & 630'W, Lagoon 700'S & 2850 W Both From The NE Corner Of Section 12

SCALE: 1" = 1320'

FINAL PROOF SURVEY UNDER

R-65488 R-9200
Application No. 66885... Permit No. 48107.....
IN NAME OF

.....ELDON.....HARROLD.....

Surveyed JUNE 4... 1920., by J.M. WARREN...