


T.4S., R.5W., W.M.

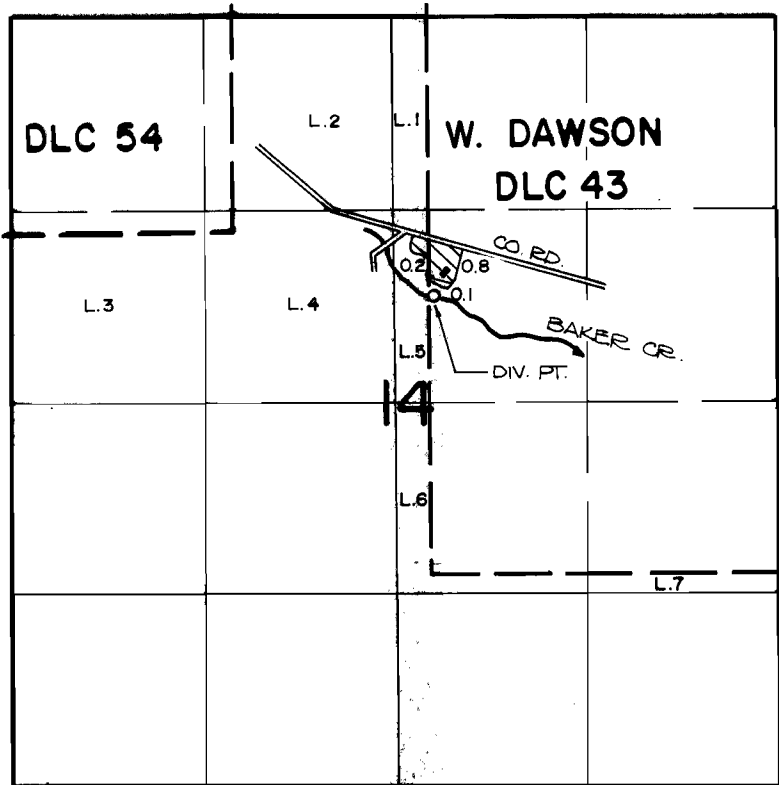

DIV. PT. LOCATION: 1910 FT. S. AND 2380 FT. W. FROM
THE N.E. CORNER OF SECTION 14.



SCALE: 4" = 1 MILE

FINAL PROOF SURVEY UNDER

Application No. 66668.. Permit No. 48104.....
IN NAME OF

.....**DAVID N. HECKEROTH**.....

Surveyed **JULY 25, 1984.**, by *P. Proctor*.....