


T.29S., R.5W., W.M.

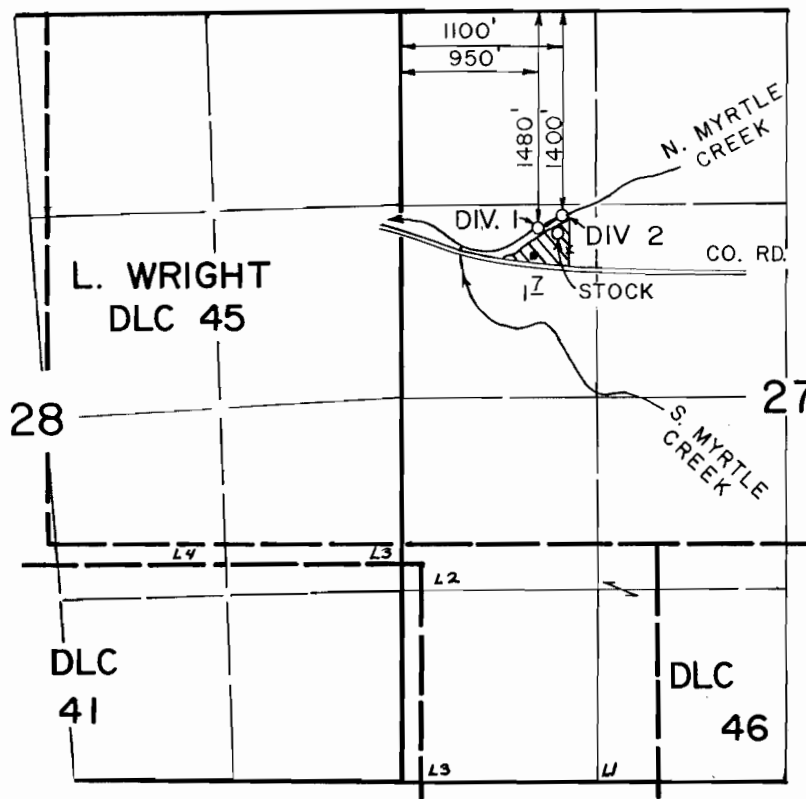

SCALE: 4" = 1 mile

**FINAL PROOF SURVEY**  
UNDER

Application No. 67095.. Permit No. 48176.....  
IN NAME OF

**TIM SEALS**

Surveyed MAY 18, 1984, by *J.E. Carhion*...