


T. 24 S., R. 7 W., W.M. SECTION 13

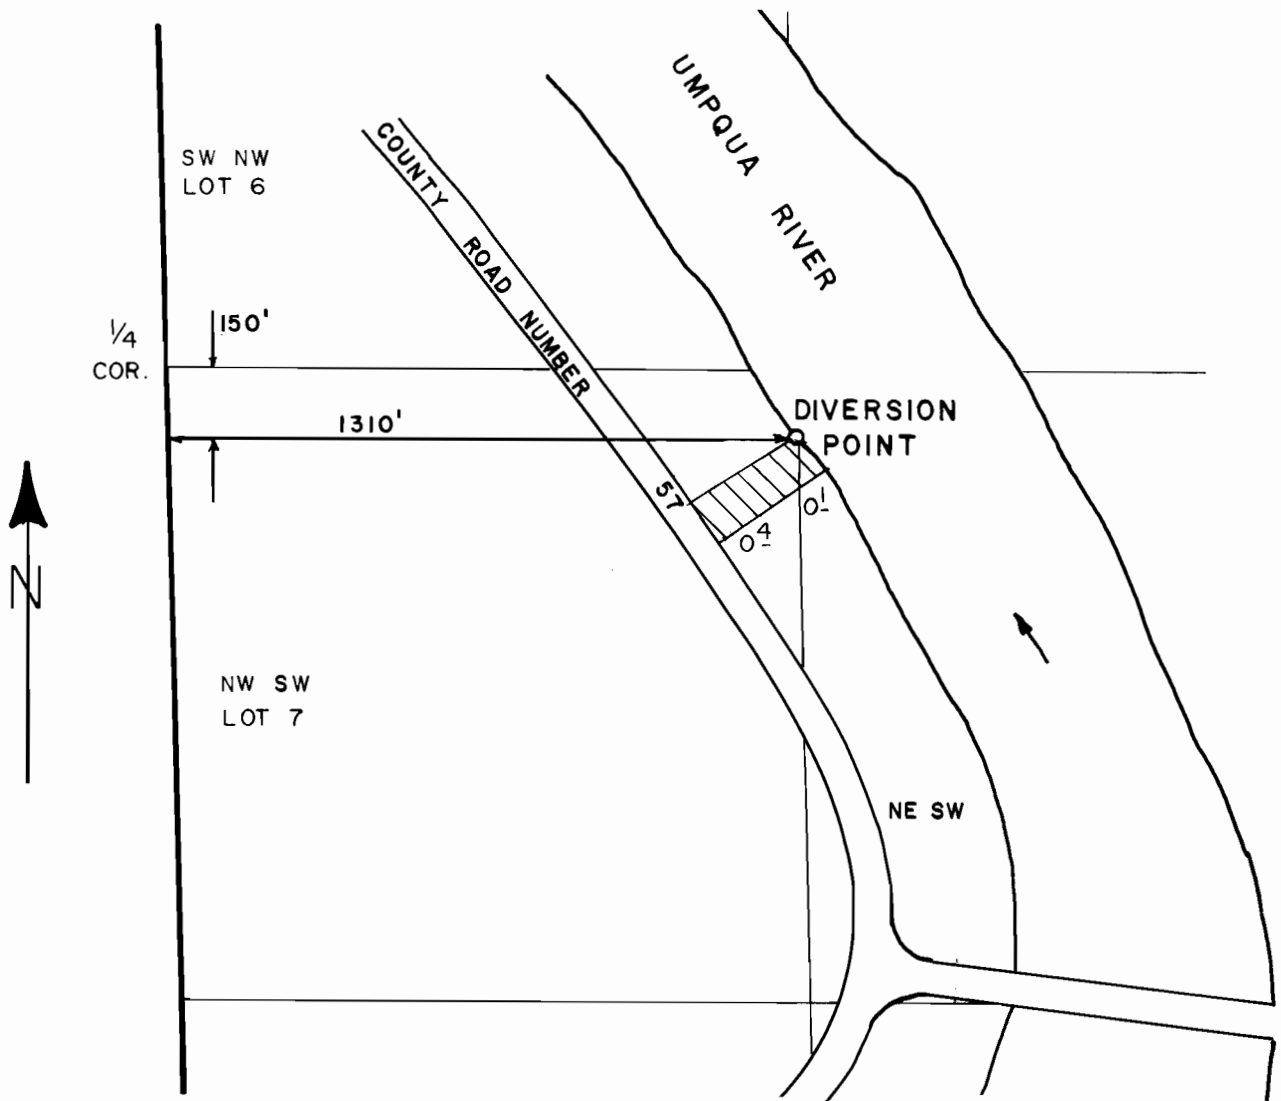

SCALE: 1" = 400'

FINAL PROOF SURVEY UNDER

Application No. 67332 Permit No. 48152
IN NAME OF

JAMES A. BILLINGSLEY

Surveyed AUG. 12. 1987., by J.M. SCHMORDE