


T. 29 S., R. 6 W., W.M.

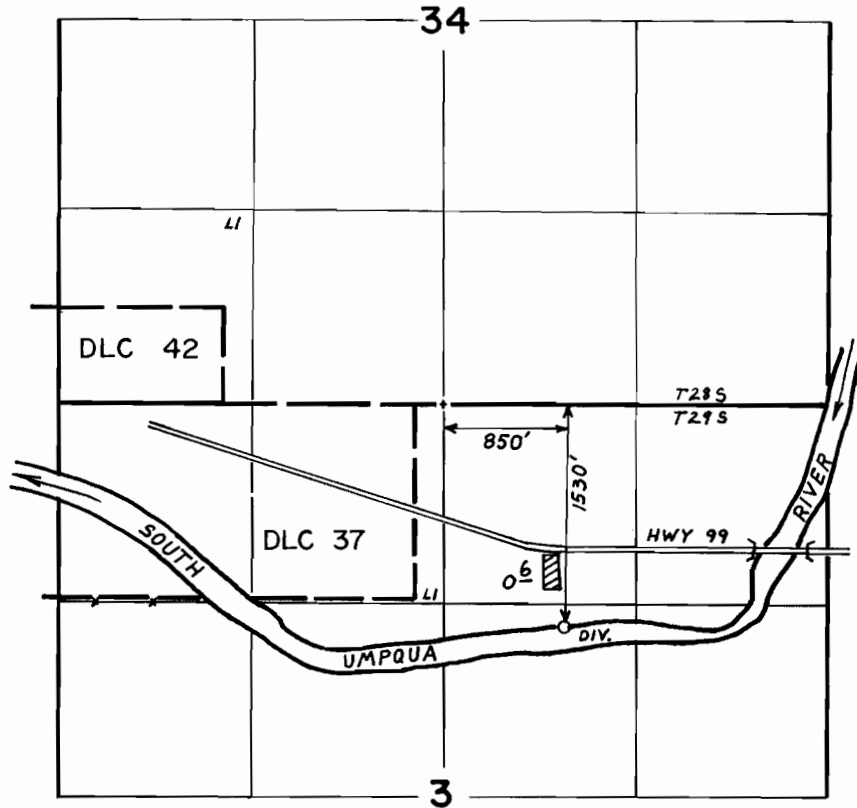

SCALE: 4" = 1 mile

FINAL PROOF SURVEY
UNDER

Application No. 67441... Permit No. 48196.....

IN NAME OF

.....CLYDE L. WHITSON.....

Surveyed JUN...27... 1984., by *L.E. Cashion*.....