


T.1N, R.2E, W.M.

SECTION 23

RECEIVED

APR 06 1990

WATER RESOURCES DEPT.
SALEM, OREGON

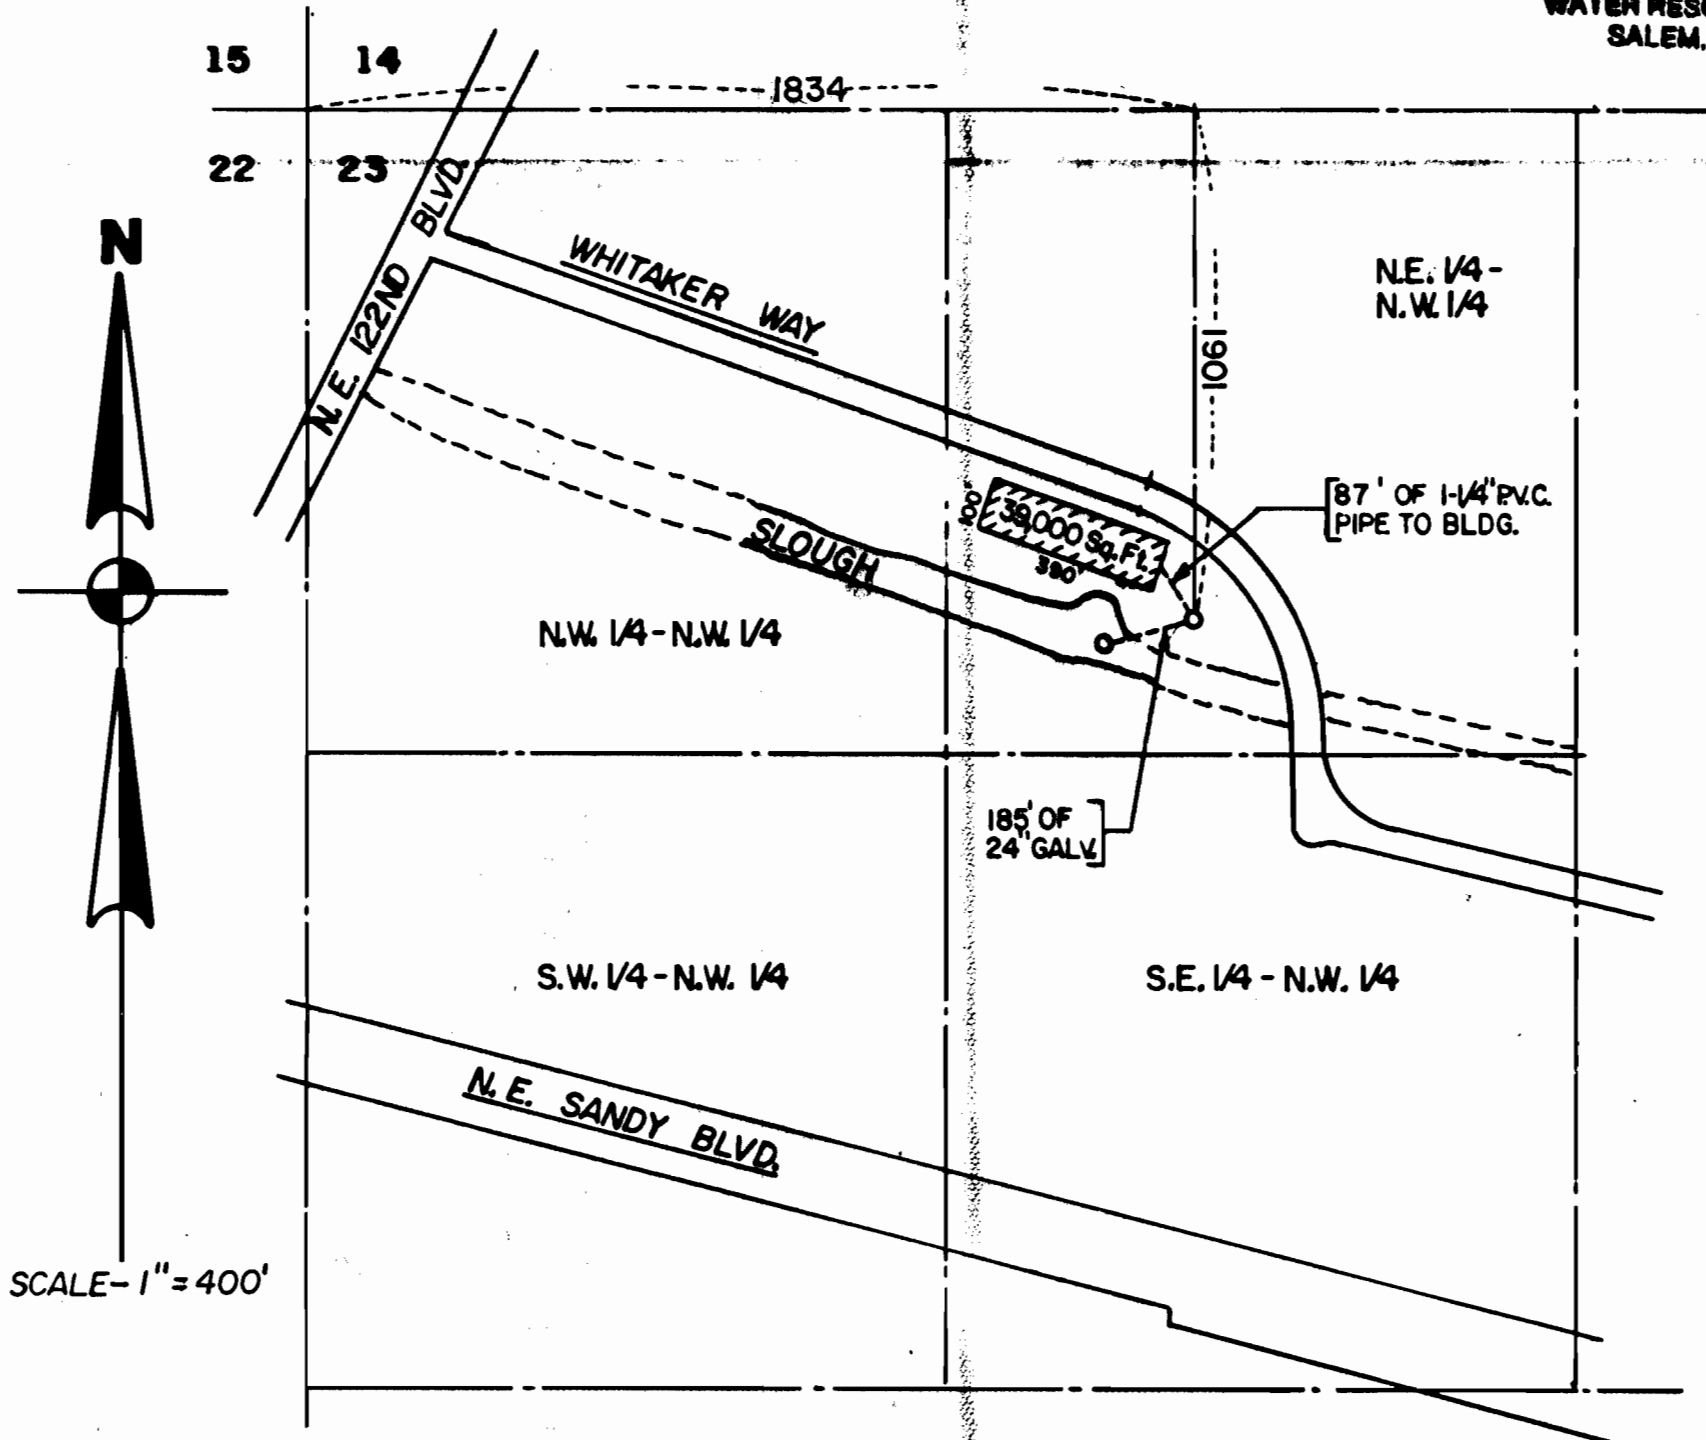

FINAL PROOF SURVEY

UNDER

Application No. 69464 Permit No. 50240

IN NAME OF

MILLER PAINT CO. INC

Surveyed 6-22-89, 1989, By RONALD G. TATONE



ORIGINAL
MAP FILE
C-14-20

	ZAROSINSKI - TATONE ENGINEERS, INC.
	3737 S.E. 8TH AVENUE, PORTLAND, OREGON 97206
	PHONE: (503) 238-6785