

FINAL PROOF SURVEY MAP

IN THE NAME OF EUGENE H. FISHER


SECTIONS 21, 22, 27, AND 28, T23S, R7W, W.M.

APPLICATION 69921

PERMIT 50744



1 INCH = 1320 FEET

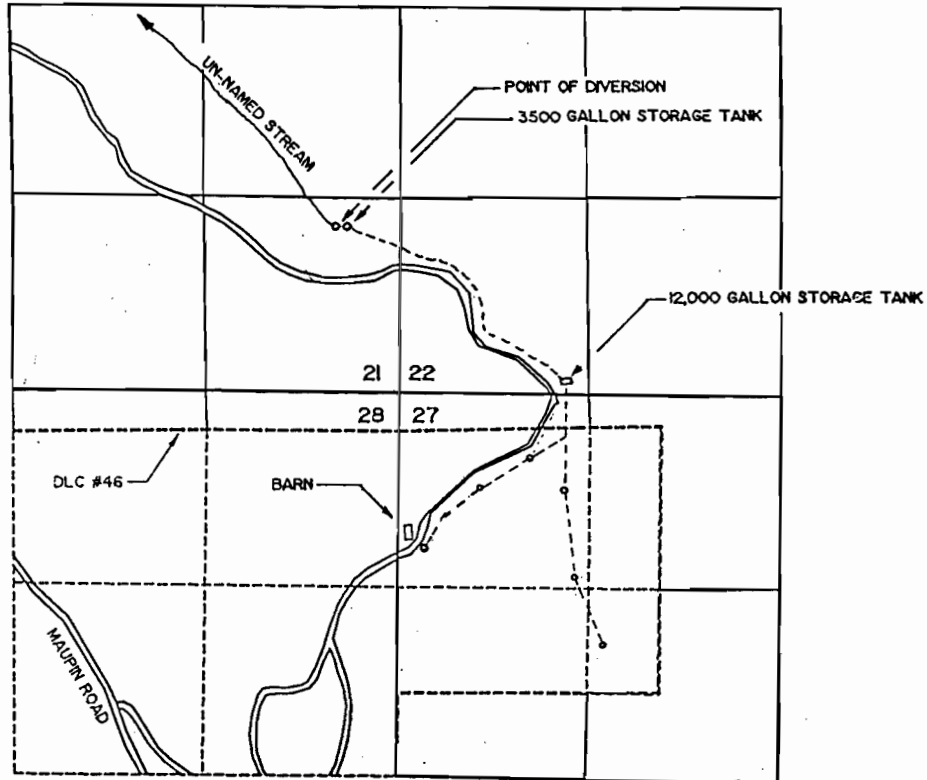

THE POINT OF DIVERSION IS LOCATED 1140 FEET NORTH AND 450 FEET WEST FROM THE SOUTHEAST CORNER OF SECTION 21, BEING WITHIN THE SE 1/4 OF THE SE 1/4 OF SECTION 21, TOWNSHIP 23 SOUTH, RANGE 7 WEST, W. M. DOUGLAS COUNTY.

THE PURPOSE OF THIS MAP IS TO IDENTIFY THE LOCATION OF THE WATER RIGHT. IT IS NOT INTENDED TO PROVIDE INFORMATION RELATIVE TO THE LOCATION OF PROPERTY OWNERSHIP BOUNDARY LINES.

