


T. 35 S., R. 2 W., W. M.

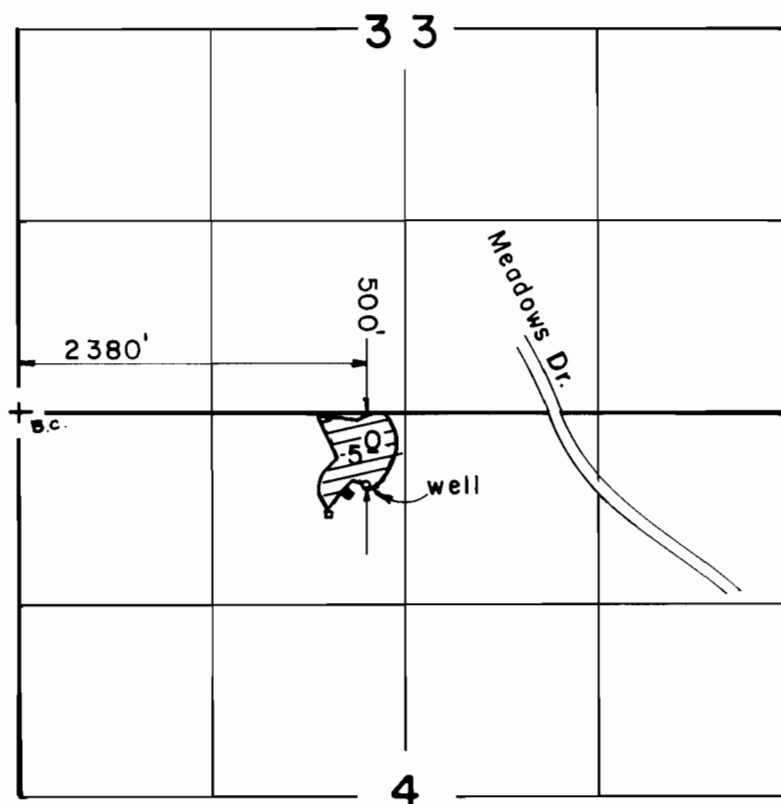

Scale: 1" = 1320'

FINAL PROOF SURVEY UNDER

Application No. G:5787 Permit No. G:5556....
IN NAME OF

.....KENNETH STRUCK.....

Surveyed FEB. 27. 1990, by B. S. JAMES....