
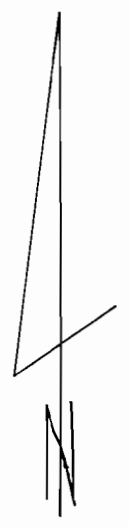


T. 7 S., R. 46 E., W.M.

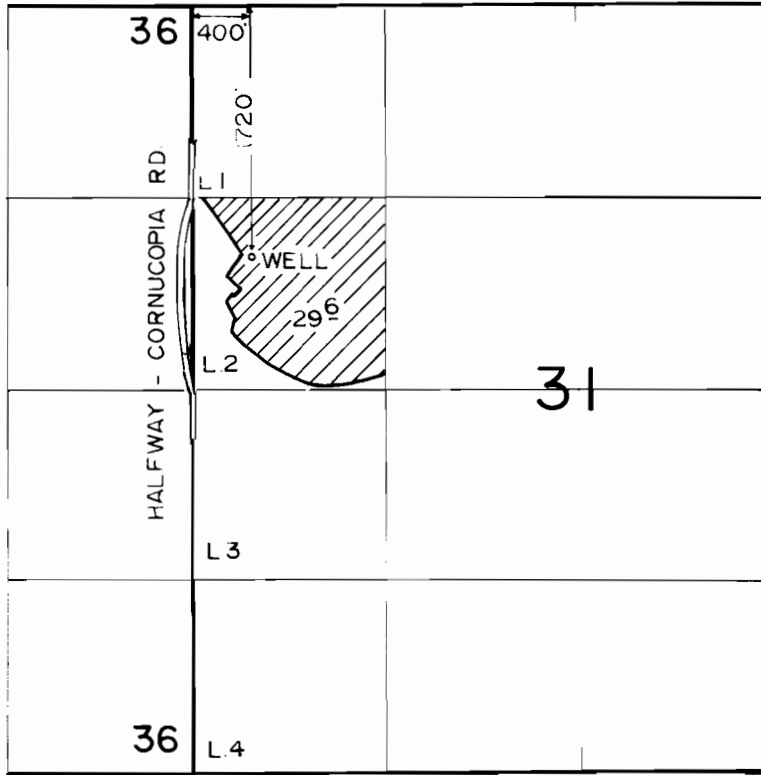

1" = 1320'

FINAL PROOF SURVEY
UNDER

Application No. G-7842 Permit No. G-7277
IN NAME OF

EMMA JEAN GREENER

Surveyed JULY 14 1982 by V.L. CHURCH
MAY 22 90 V.L. CHURCH