



T.6S.,R.1W.,W.M.

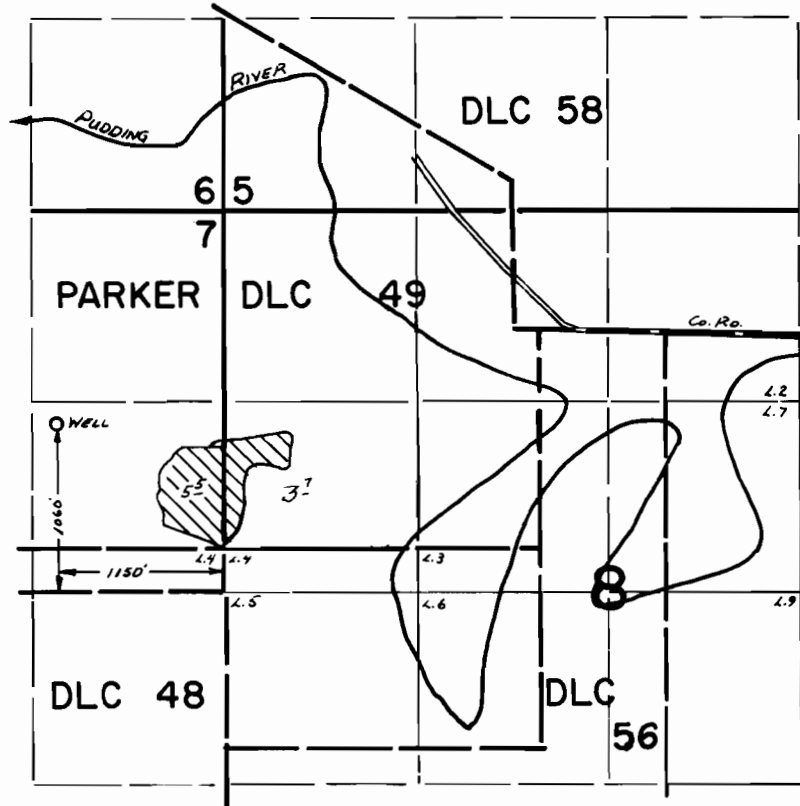

 - Supplemental

FINAL PROOF SURVEY UNDER

Application No. G-7928 Permit No. G-7315
IN NAME OF

MELVIN KAUFMAN

Surveyed Oct. 15, 1981, by S. C. BROWN