
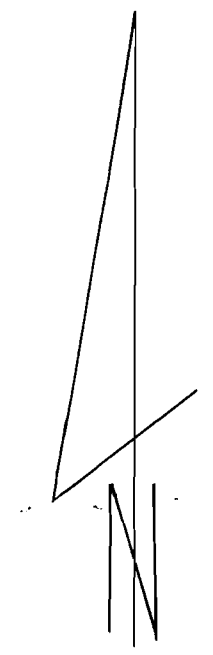


T. 8 S., R. 16 E., W.M.

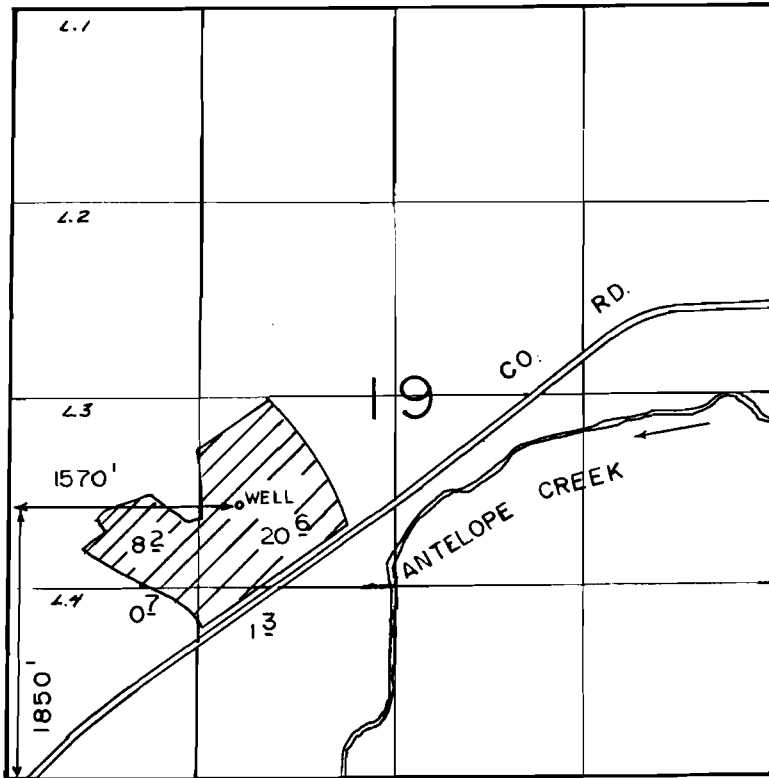

1" = 1320'

**FINAL PROOF SURVEY**  
**UNDER**

Application No. G 8687 Permit No. G 9006

*C-66556*

IN NAME OF

MARY FOLMSBEE

Surveyed MAY 22 1990., by B.W. BISHOP

5-8-91 DSM  
41065-279-51R

G-9006