


G-8456
66557

T. 38 S., R. 20 E., W.M.

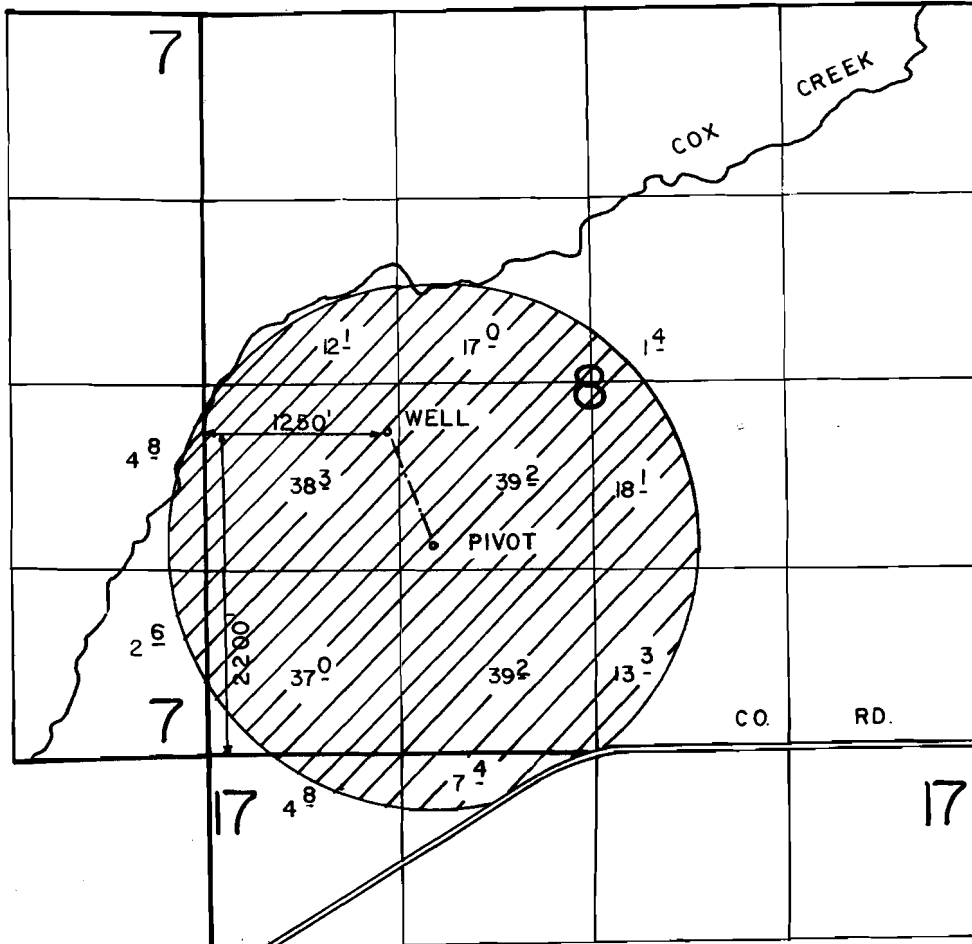

FINAL PROOF SURVEY
UNDER

1" = 1320'

Application No. G-9078 Permit No. G-8456
IN NAME OF Cert # 66557

MAXWELL CATTLE INC.

Surveyed AUGUST 22, 1990, by B W BISHOP

5-22-91 DSM
41037-379-74C