


T. 15 S., R. 11 E., W.M.

SEC. 4

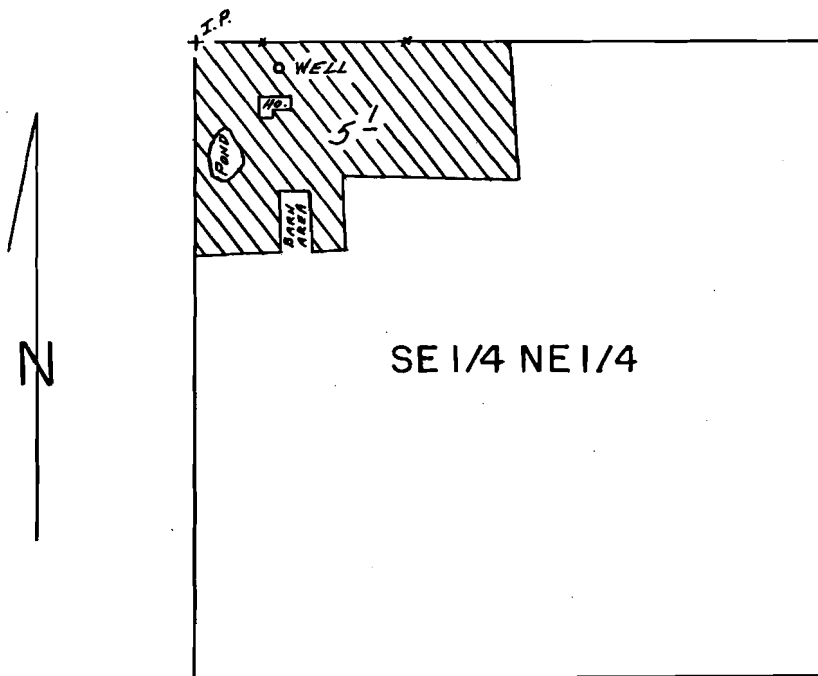

WELL LOC.: 55' S. & 175' E. FROM NW COR. SE 1/4 NE 1/4 SEC. 4

SCALE: 1" = 400'

FINAL PROOF SURVEY UNDER

Application No. G-10181. Permit No. G-9220...
IN NAME OF

.....DAVID W. KELL.....

Surveyed July 30, 1990, by B.W. BISHOP.....

Recd 8-26-91 WDA:11

PTS 11/1/91 PWB
G 9220