
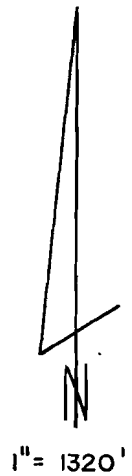


6-9247
66559

T. 37 S., R. 20 E., W.M.

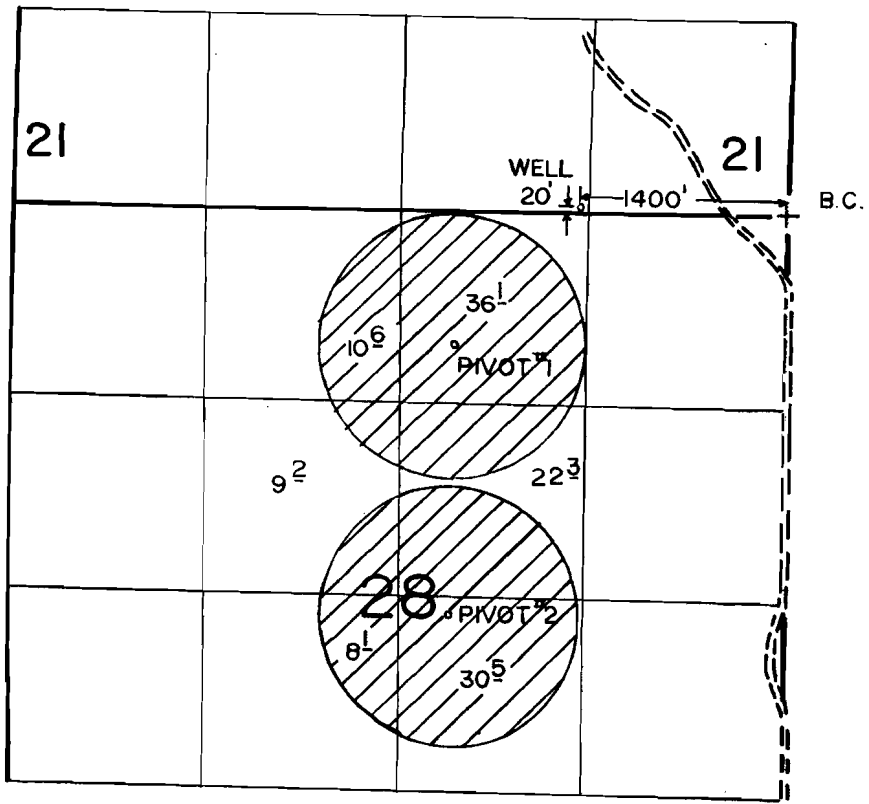

FINAL PROOF SURVEY
UNDER

Application No. G-10275 Permit No. G-9299
IN NAME OF Cert #66559

BERMUDA RESEARCH INC.

Surveyed AUG. 29 1990 by B W BISHOP

2-7-91 DSM
PTS 11-1990