


T. 37 S., R. 20 E. W.M.

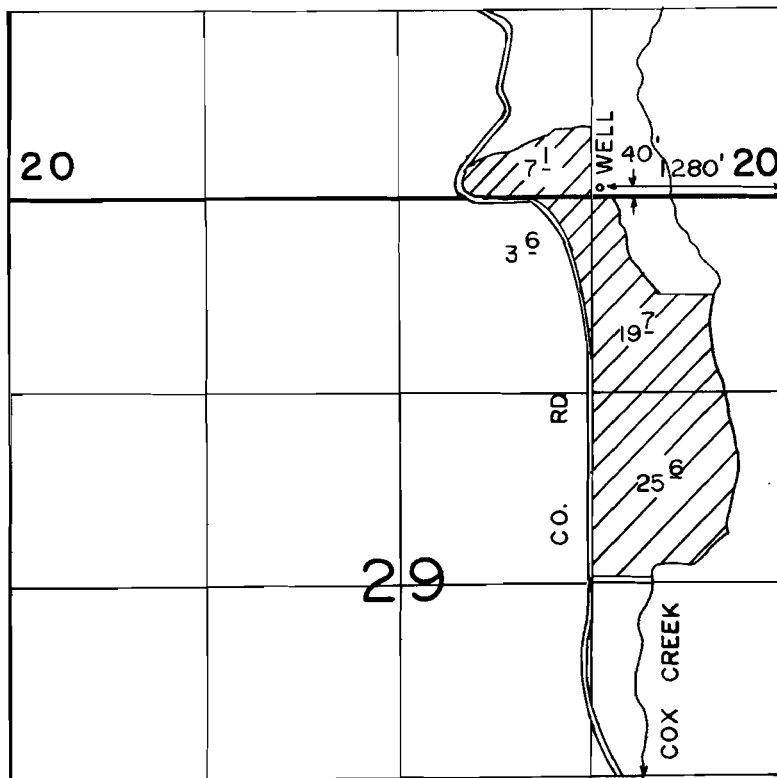

1" = 1320'

FINAL PROOF SURVEY
UNDER

Application No. G-10480 Permit No. G-9874
IN NAME OF Cert. # 66560

FRANCIS FREDERICK ALLEN

Surveyed AUG. 28 19.90, by B W BISHOP

2-11-91 DSM
41037-379-76 L