


T. 37 S., R. 20 E., W.M.

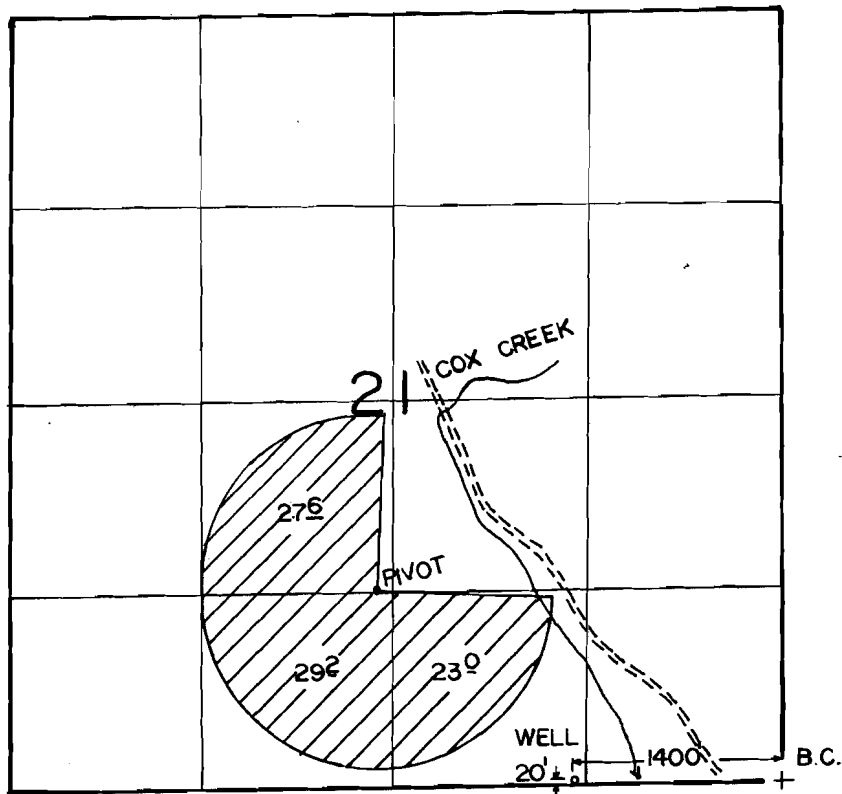

1" = 1320'



# FINAL PROOF SURVEY UNDER

Application No. G-10482 Permit No. G-9843  
IN NAME OF Cert. # 66561

FRANCIS FREDERICK ALLEN

Surveyed AUG. 28 1990, by B W BISHOP

2-7-90 DSM  
PTS 11-1990