


T. 39 S., R. 2 E., W. M.

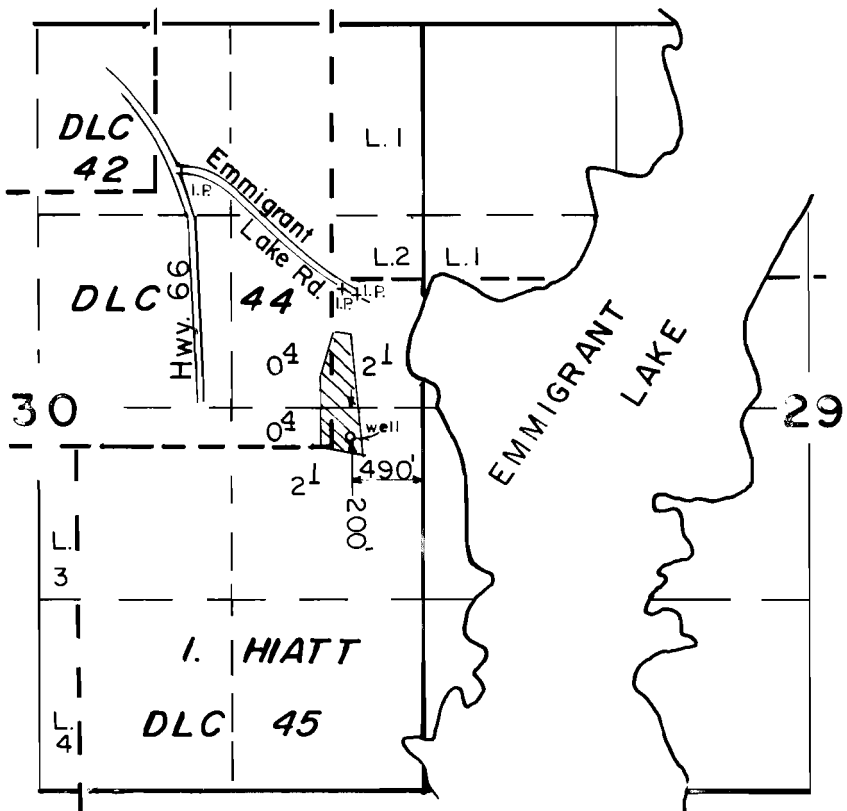

Scale: 1" = 1320'

FINAL PROOF SURVEY
UNDER

Application No. G-10493 Permit No. G-9482
IN NAME OF

RANDY WARREN

Surveyed NOV. 26, 1990, by B. S. JAMES