


T. 33 S., R. 15 W., W.M.

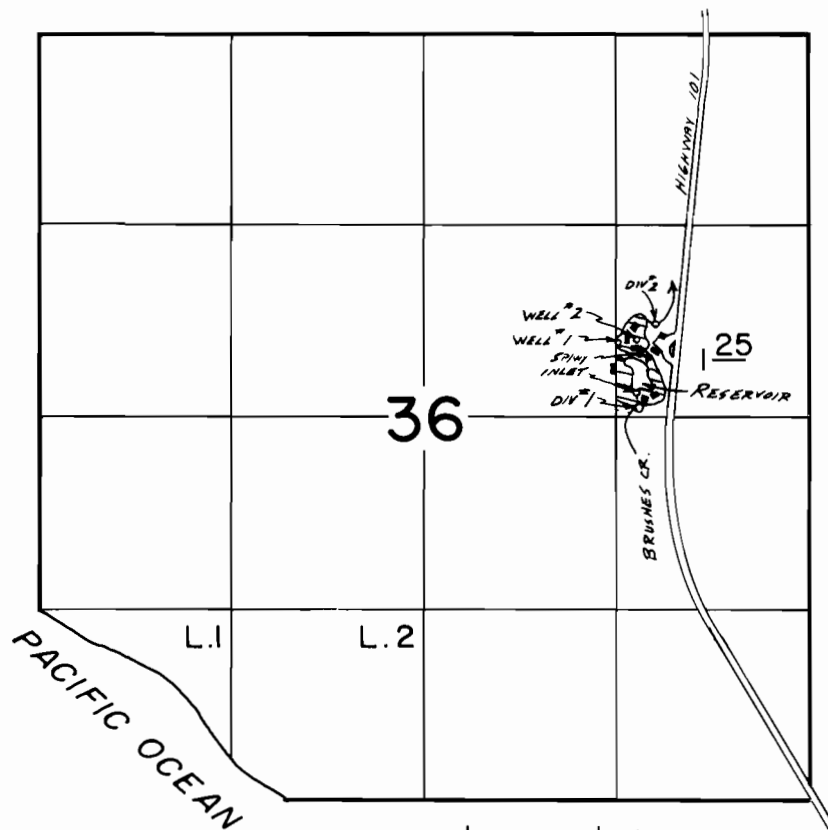

Div. Pt. 1 = 60' N & 1150' W
 Div. Pt. 2 = 740' N & 1060' W
 Well 1 = 500' N & 1310' W
 Well 2 = 540' N & 1180' W

ALL FROM E 1/4
 CORNER SEC. 36.

Scale 1" = 1320'

FINAL PROOF SURVEY

UNDER

G-10755

G-9824

R-63699

R-8451

Application No. ~~63060~~ Permit No. ~~46804~~

IN NAME OF

HUMBUG MOUNTAIN LODGE

Surveyed August 2, 1989, by B.S. JAMES