


# T. 39 S., R. 5 W., W. M.

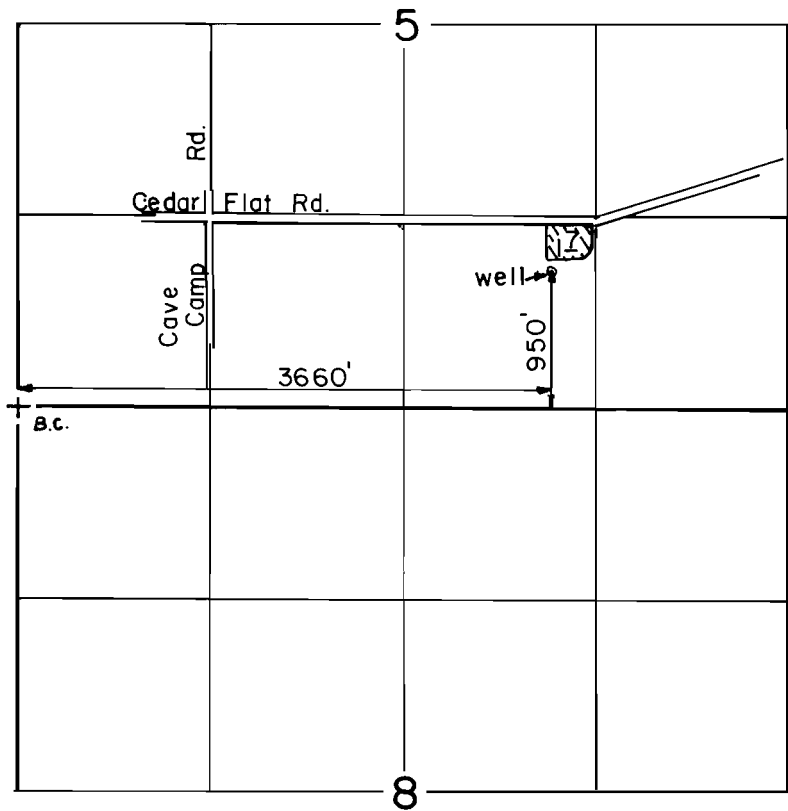

Scale: 1" = 1320'

## FINAL PROOF SURVEY UNDER

Application No. G-10968 Permit No. G-10149  
IN NAME OF

ROBERT J. NASON

Surveyed OCT. 3, 1990, by L. M. JOACHIMS