


T. 27S., R. 6 W., W.M.

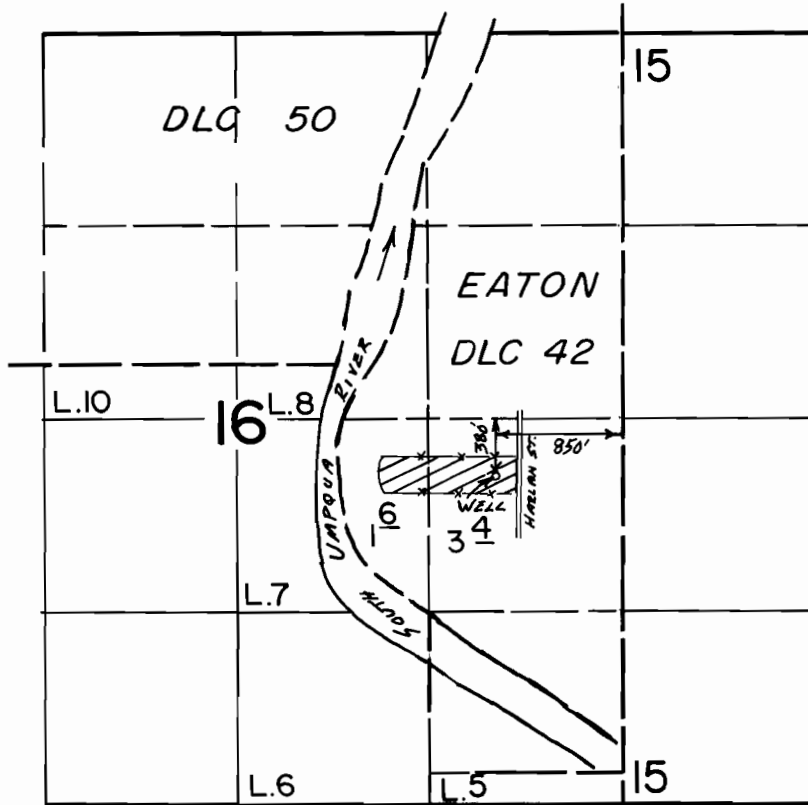

Scale 1" = 1320'

FINAL PROOF SURVEY UNDER

Application No. G-11213. Permit No. G-10310...
IN NAME OF

.....EUGENE.....BROWN.....

Surveyed Aug. 1, 1990, by B.S. James.....