


T. 41 S., R. 20 E., W.M.

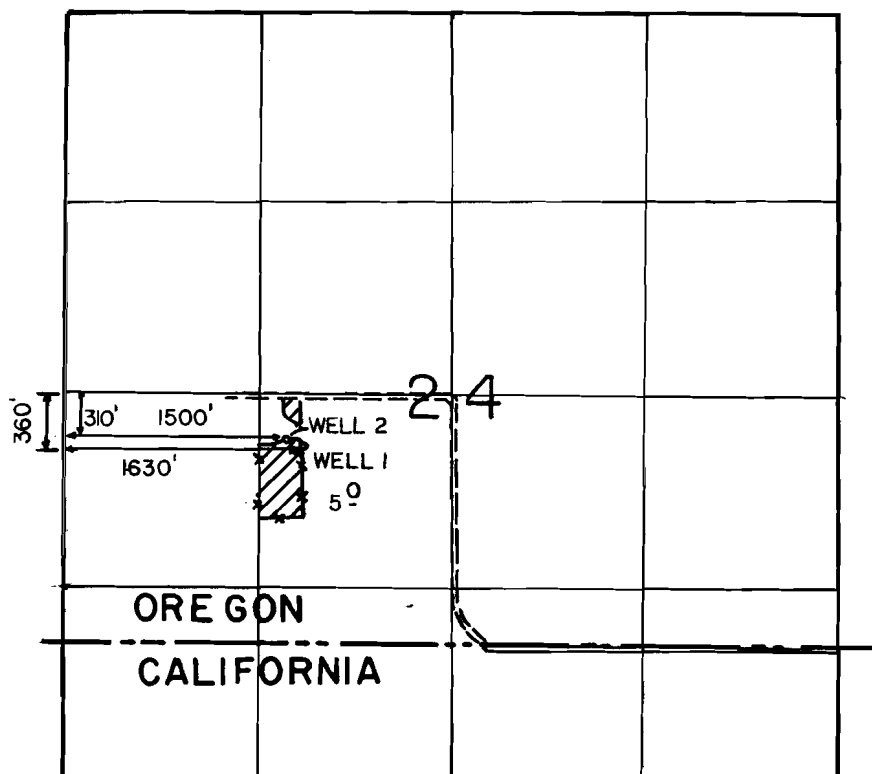

1" = 1320'

FINAL PROOF SURVEY **UNDER**

Application No. G 11307 Permit No. G 10473
IN NAME OF Cert # 66568

MEL & KAY NESTEBY

Surveyed AUG. 21 1990, by B W BISHOP

5-17-91 DSM

41037-379-171L