


T. 38 S., R. 5 W., W. M.

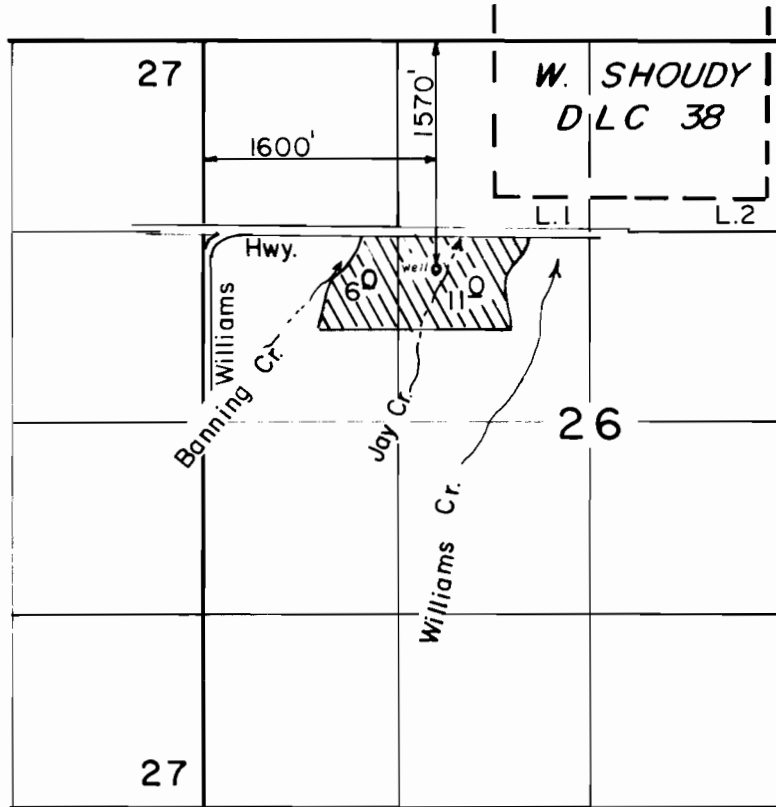

Scale: 1" = 1320'

FINAL PROOF SURVEY UNDER

Application No. G-11521. Permit No. G-10674.
IN NAME OF

RANDOLPH S. CAREY

Surveyed OCT. 3, 1990, by L.M. JOACHIMS