


T. 38 S., R. 2 & 3 W., W. M.

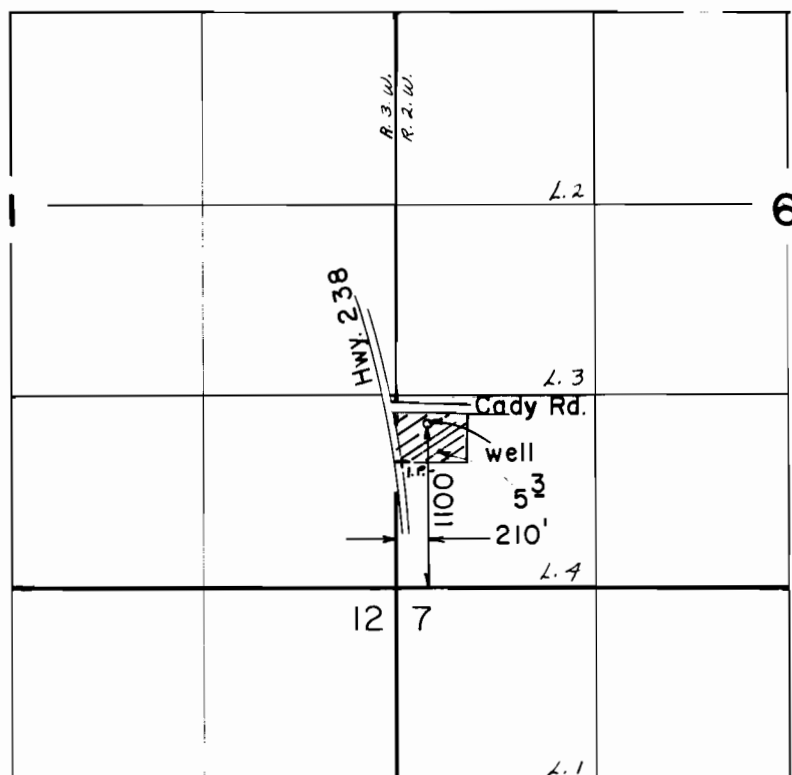

Scale: 1" = 1320'

FINAL PROOF SURVEY

UNDER

Application No. G-11539 Permit No. G-10638.
IN NAME OF

JAMES C. HOEHN

Surveyed OCT. 2, 1989, by L.M. JOACHIMS