


T. 27S., R. 13E., W.M.

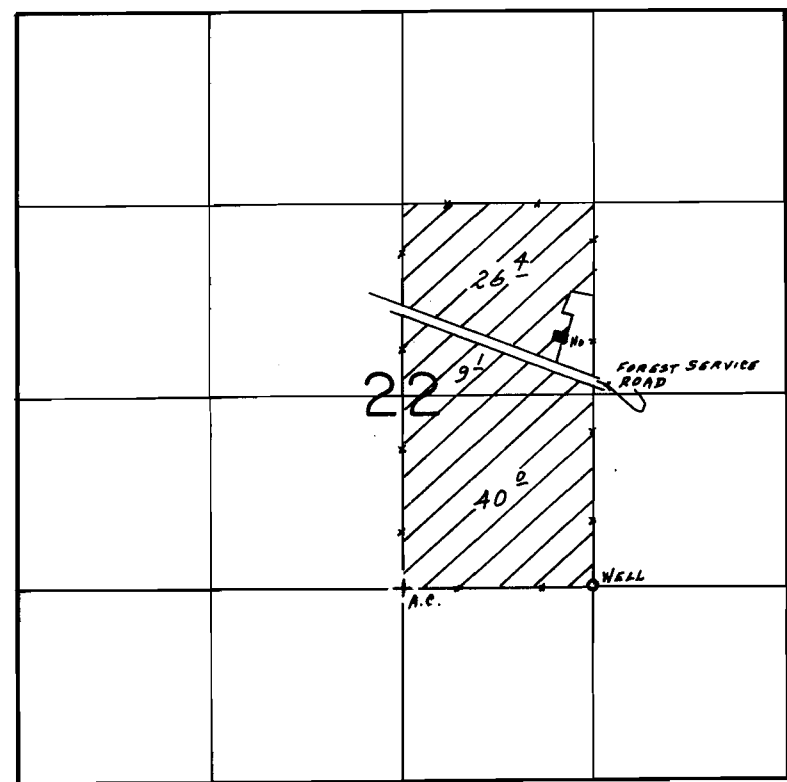

WELL LOC: 10' N. & 1310' E. FROM SW COR NW 1/4 SE 1/4 SEC. 22

SCALE: 1" = 1320'

FINAL PROOF SURVEY UNDER

Application No. ~~G-11600~~ Permit No. ~~G-10712~~.....
IN NAME OF Cert # 66571 12-15-86

.....LEON E. BAKER, JR.

Surveyed June 28, 1990, by B.W. BISHOP.....