
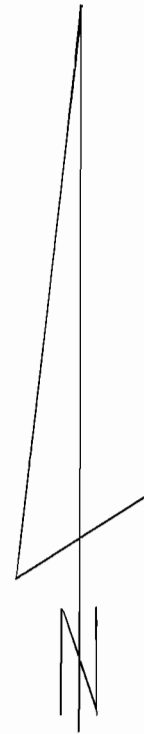


T. 8 S., R. 16 E., W.M.

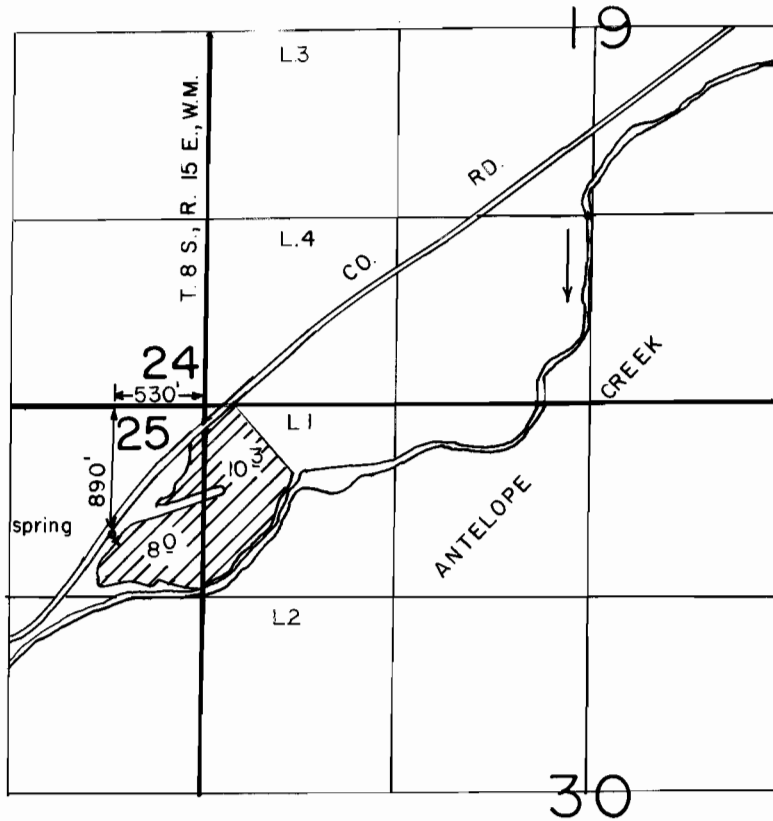

1" = 1320'

**FINAL PROOF SURVEY  
UNDER**

Application No. 47129... Permit No. 42530.....  
IN NAME OF

LARRY & MARVIN PARLETTE

Surveyed MAY 11, 1991, by B. BISHOP

5-10-91 DSM

41065-279-51R