


# T. 31 S., R. 12 W., W. M.

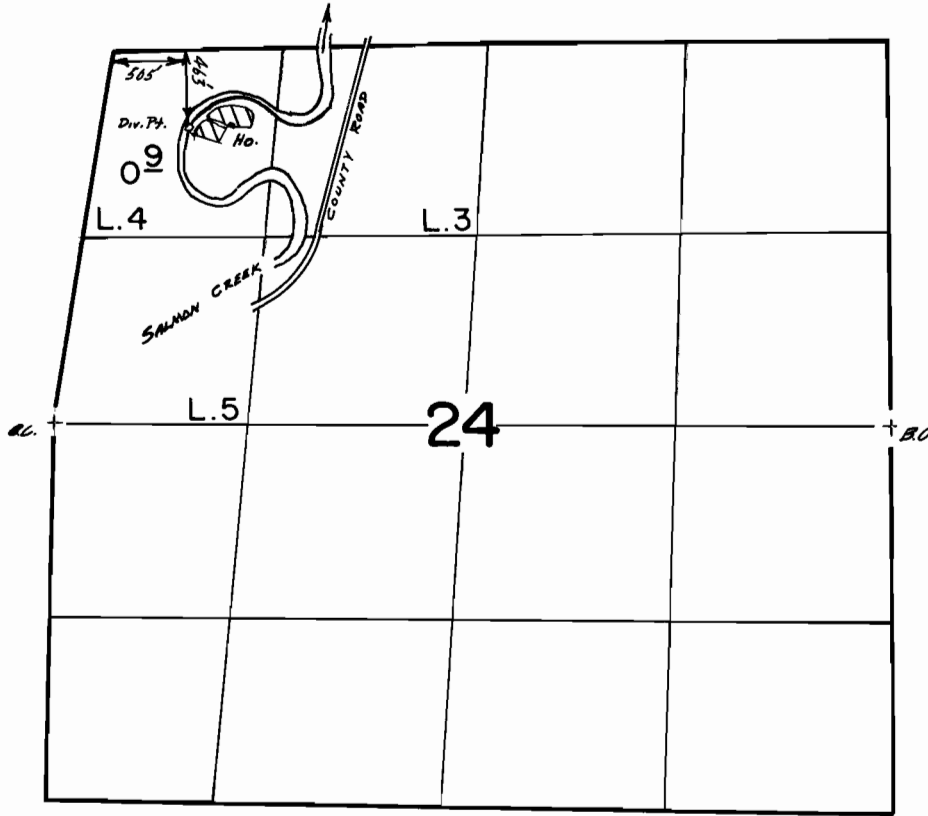

Scale 1" = 1320'

## FINAL PROOF SURVEY UNDER

Application No. ~~49759~~ Permit No. ~~37256~~....  
IN NAME OF

STUART B. & LAURA S. SLATTERY

Surveyed Aug. 31, 1988, by J. M. Schmorde