


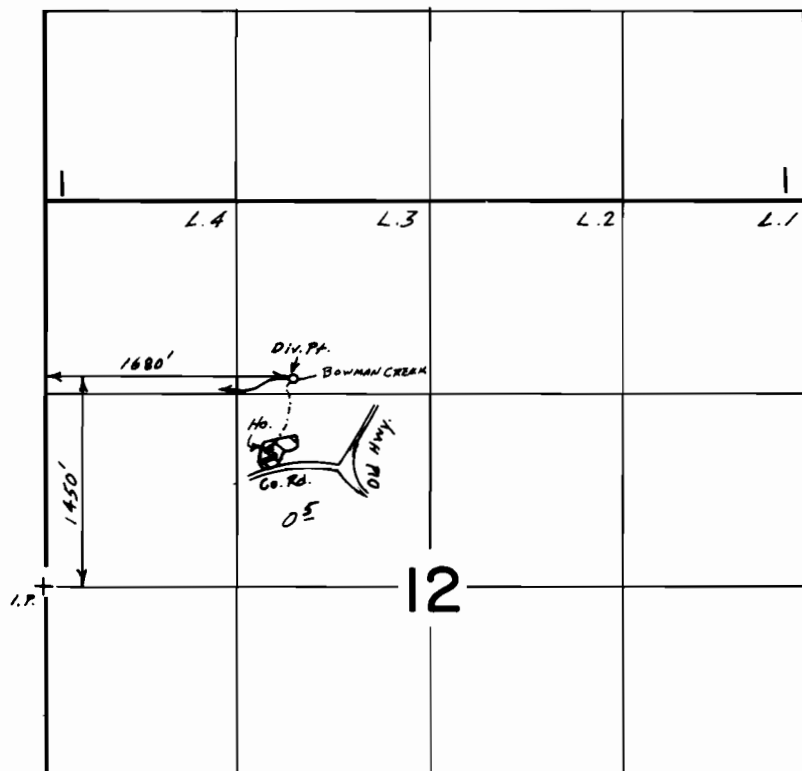

Scale 1"=1320'

FINAL PROOF SURVEY

UNDER

Application No. 51241... Permit No. 38706...
IN NAME OF

EBBE R. & SARA M. NELSON.....

Surveyed Sept. 30, 1987, by J. KAUPPILA