


# T. 28S., R.12 &13 W., W.M.

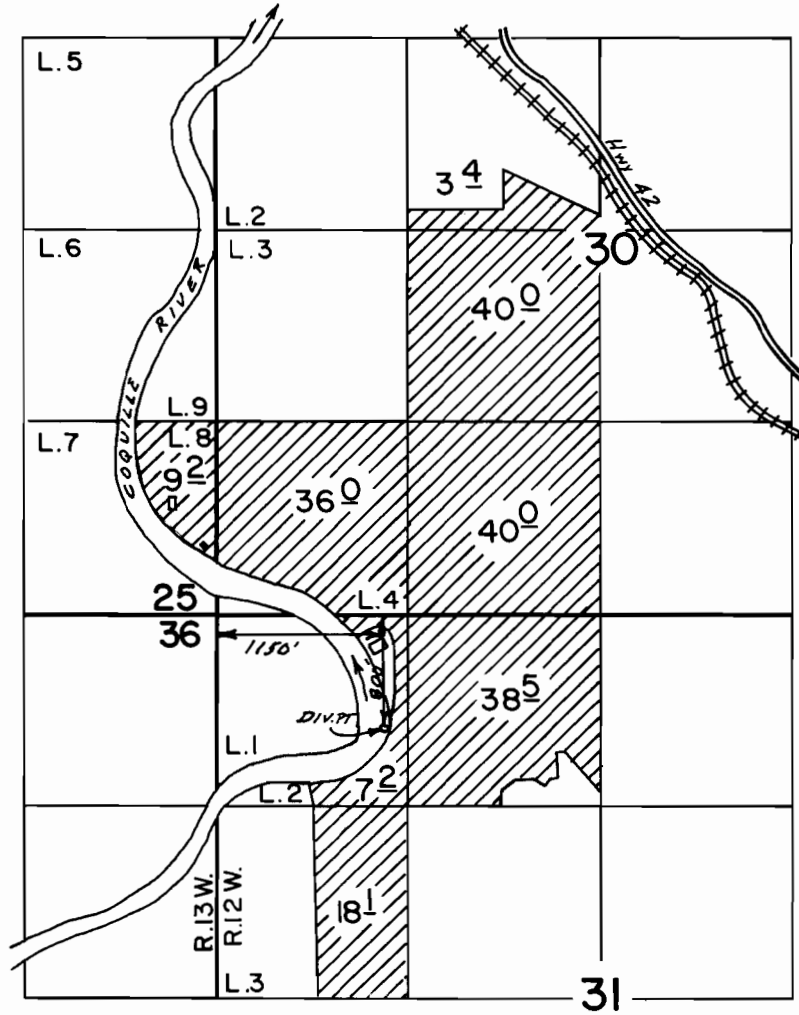

Scale 1"=1320'

## FINAL PROOF SURVEY UNDER

Application No. 51616... Permit No. 38931.....  
IN NAME OF

CHARLES J. & MABEL V. LEIBELT

Surveyed Oct..10,.. 1983, by L.E. CASHION