


T. 1 N., R. 4 W., W.M.

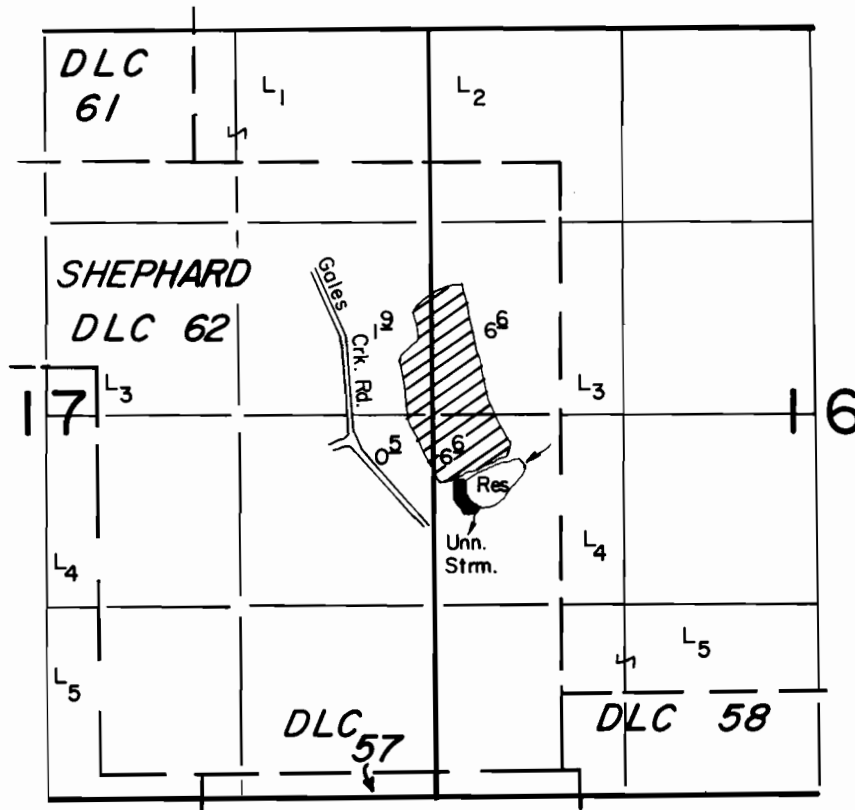

P.O.D. Loc. : 2380' S. & 560' W. from NE Cor. DLC 62.

Scale : 1" = 1320'

**FINAL PROOF SURVEY**  
UNDER

R-56062

R-6578

Application No. 56063 Permit No. 41546

IN NAME OF

**PAUL CHOBAN**

Surveyed AUG. 8 1988, by T. Warren