


T. 1 N., R. 4 W., W.M.

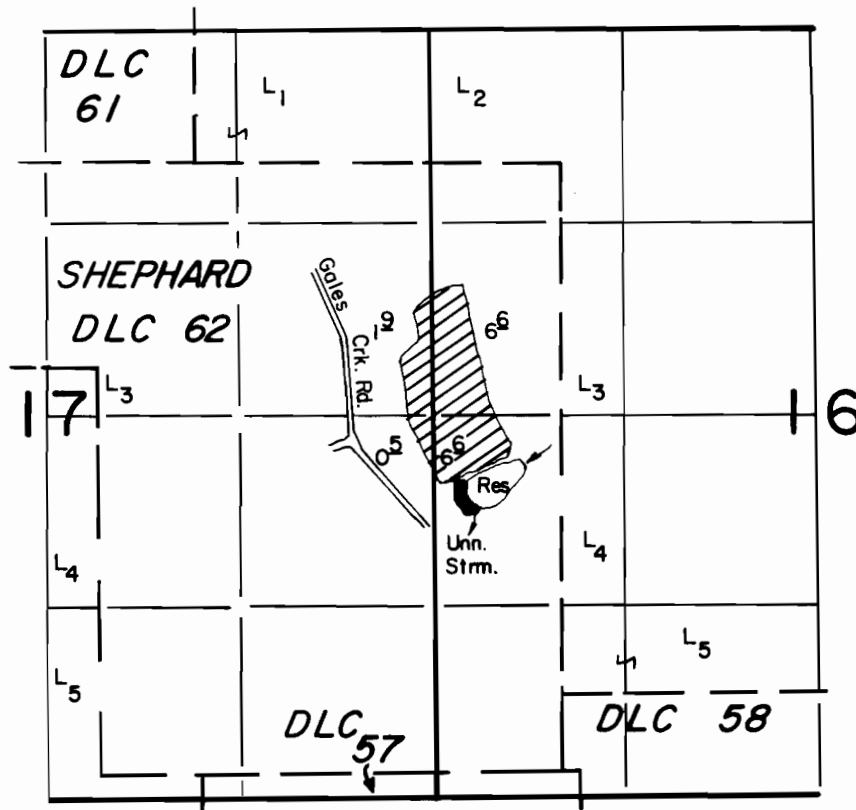

P.O.D. Loc. : 2380' S. & 560' W. from NE Cor. DLC 62.

Scale : 1" = 1320'

**FINAL PROOF SURVEY**  
UNDER

R-56062                      R-6578  
 Application No. 56063      Permit No. 41546  
 IN NAME OF

**PAUL CHOBAN**

Surveyed AUG. 8 1988, by T. Warren