

43780

SCHNEIDER 66580

TOWNSHIP 41 S., RANGE 4 E. W.M.
SECTION 16 JACKSON COUNTY, ORE.

SCALE: 1 MILE = 4 INCHES



Application No. 58009

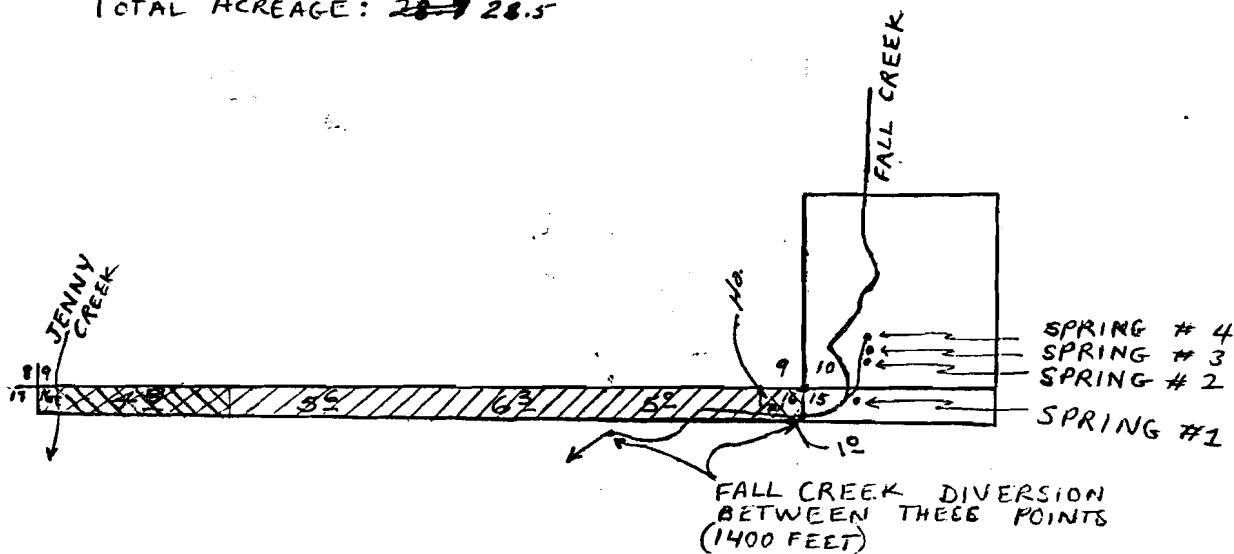
Permit No. 43780

RECEIVED

OCT 19 1978

WATER RESOURCES DEPT.
SALEM, OREGON☒ SPRINGS[#] SUPPLEMENTED BY FALL CREEK (1 ACRE)☒ FALL CREEK (¹⁷1 ACRES)

☒ JENNY CREEK SUPPLEMENTED BY FALL CREEK (4.8 ACRES)

TOTAL ACREAGE: ~~28.7~~ 28.5

DIVERSION POINTS:

SPRING #1: 41'S. AND 351'E. FROM THE NW COR. SEC. 15 WITHIN THE NW¹/₄ NW¹/₄ SEC. 15

SPRING #2: 67'N. AND 351'E

SPRING #3: 91'N AND 351'E

SPRING #4: 197'N AND 351'E ALL FROM THE SW COR. OF SEC. 10 WITHIN THE SW¹/₄ SW¹/₄ SEC. 10FALL CREEK: 300'S AND 1400'W FROM THE NE COR. OF SEC. 16 WITHIN THE NW¹/₄ NE¹/₄ SEC. 16JENNY CREEK: 50'S AND 250'E. FROM THE NW COR. OF SEC. 16 WITHIN THE NW¹/₄ NW¹/₄ SEC. 16

ALL IN T. 41 S. R. 4 E. W. M.