


T. 26 S., R. 4 W., W. M.

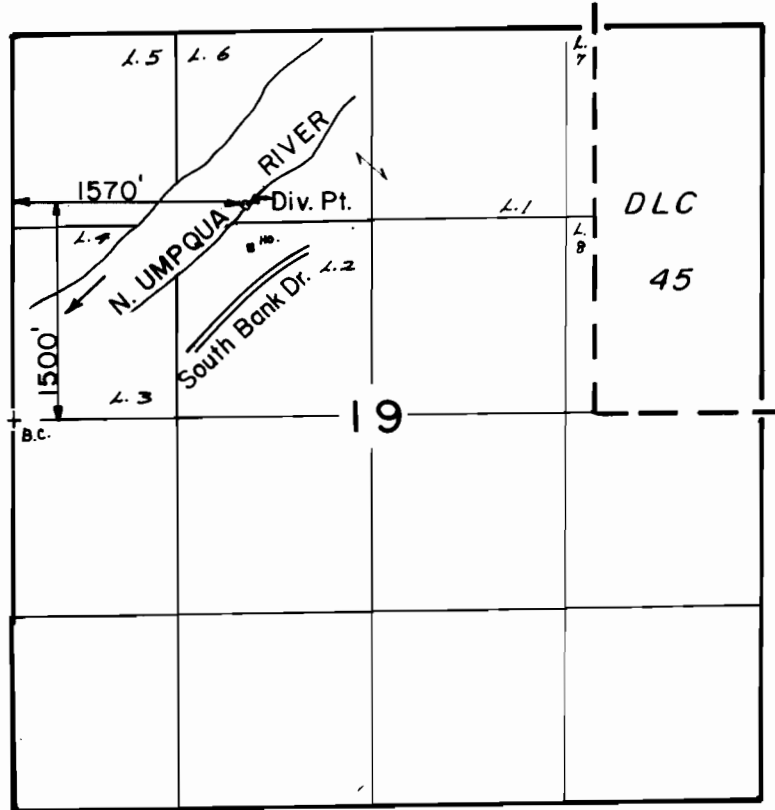

Scale: 1" = 1320'

FINAL PROOF SURVEY
UNDER

Application No. 58057.. Permit No. 43791.....
IN NAME OF

JOHN & SUZANNE GATES

Surveyed OCT. 23, 1990, by B. S. JAMES...