


T. 5 & 6 S., R. 5 W., W. M.

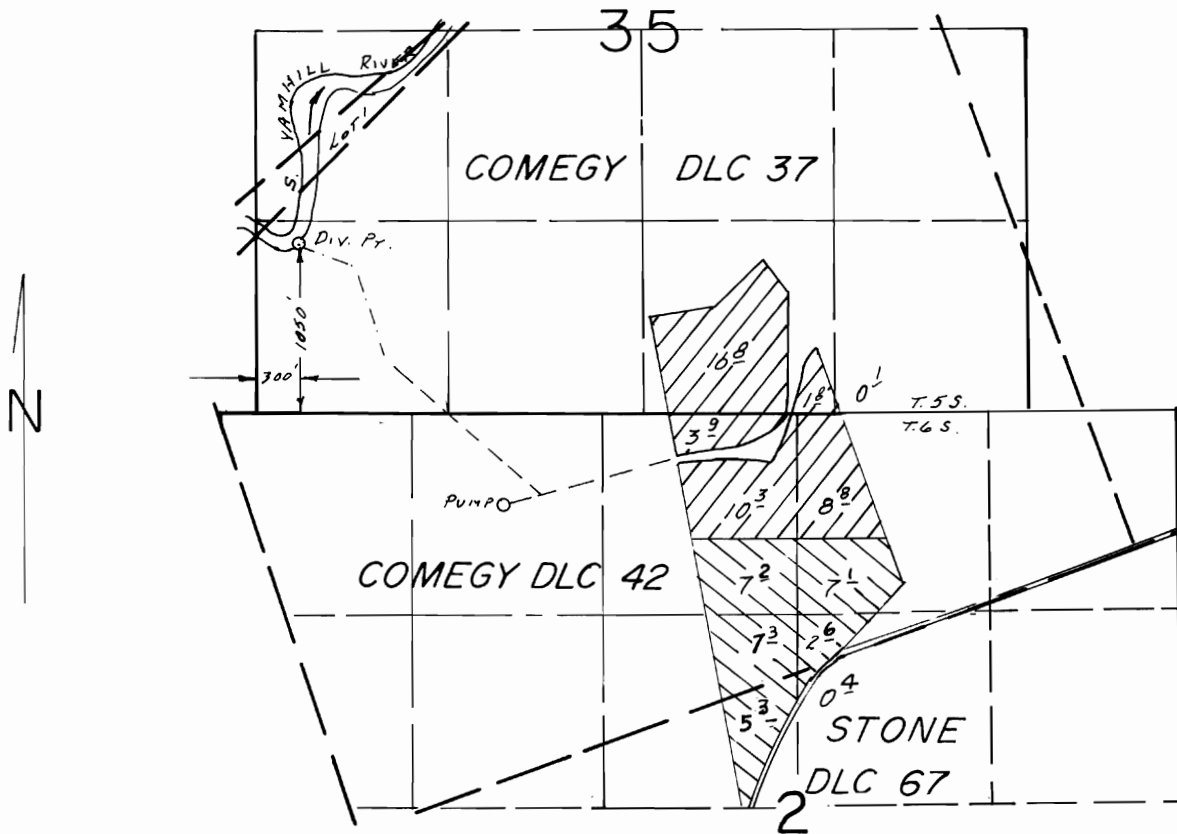

SCALE: 1" = 1320'

### FINAL PROOF SURVEY

UNDER

Transfer No. 4137



Application No. 58248.. Permit No. 44042.....



IN NAME OF

.....R. L. WALKER FARMS, INC.....

Surveyed Sept. 25, 1987, by B. W. BISHOP.....

3/9/89  
41071-178-75C RWB  
41053-178-213A