




T.5S., R.5W., W.M.

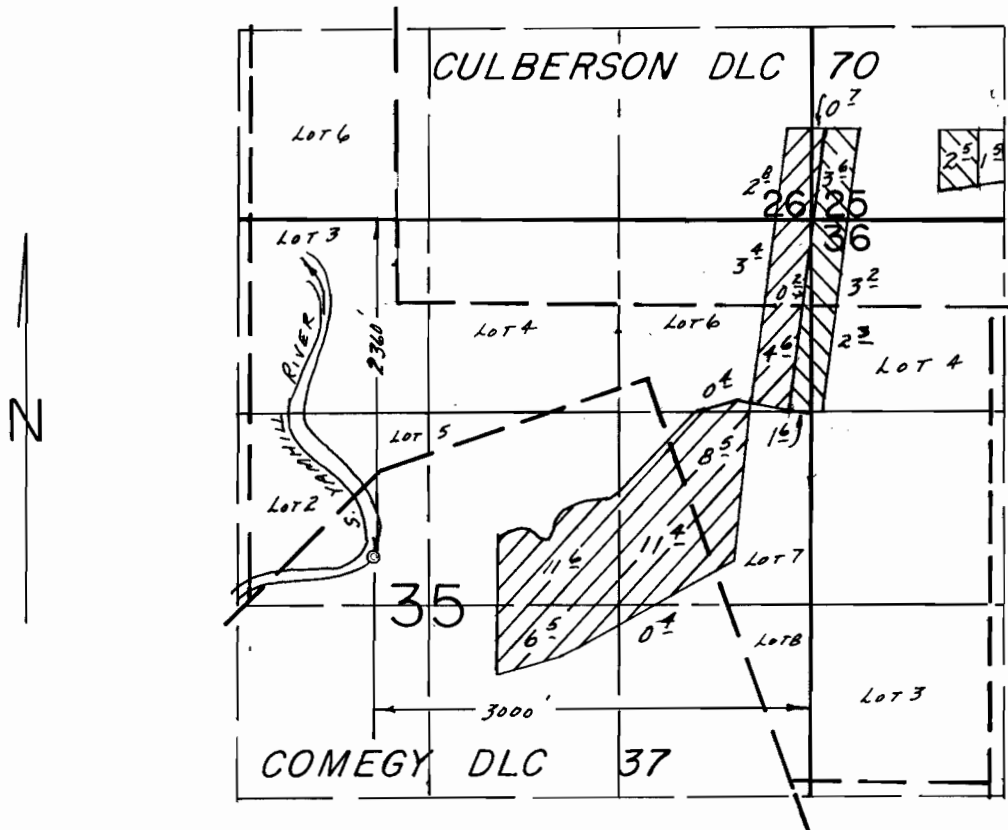

SCALE: 1" = 1320'

FINAL PROOF SURVEY UNDER

Transfer No. 3625  PORTION ONLY
Application No. 61845 Permit No. 46247  PORTION ONLY
IN NAME OF

R. L. WALKER FARMS, INC.

Surveyed Sept. 25 1987, by B. W. BISHOP

MAP # 20F2

41053-178-213A
41071-178-75C

3/13/89
BWB