


# T. 33 S., R. 2 E., W.M.

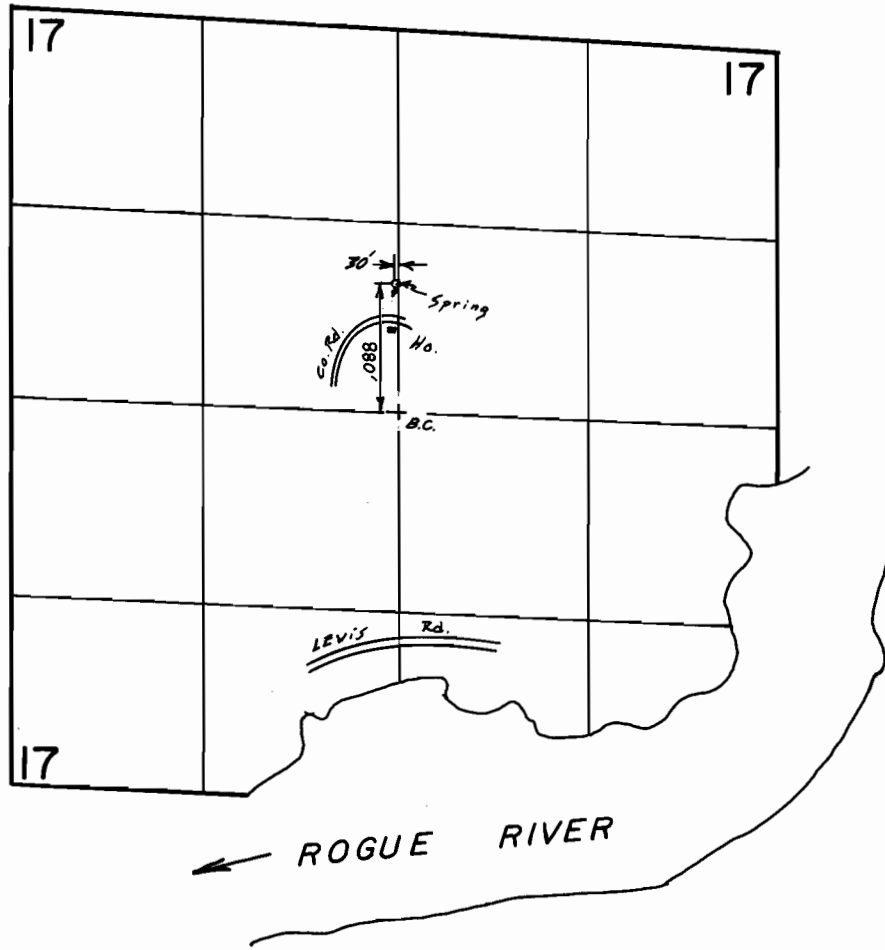

Scale 1" = 1320'

## FINAL PROOF SURVEY UNDER

Application No. 58387. Permit No. 44059.....  
IN NAME OF

...VENSON &/or DONNA M. VAUGHAN

Surveyed Oct. 18, 1990, by B.S. James.....