


T. 40S., R. 14W., W.M.

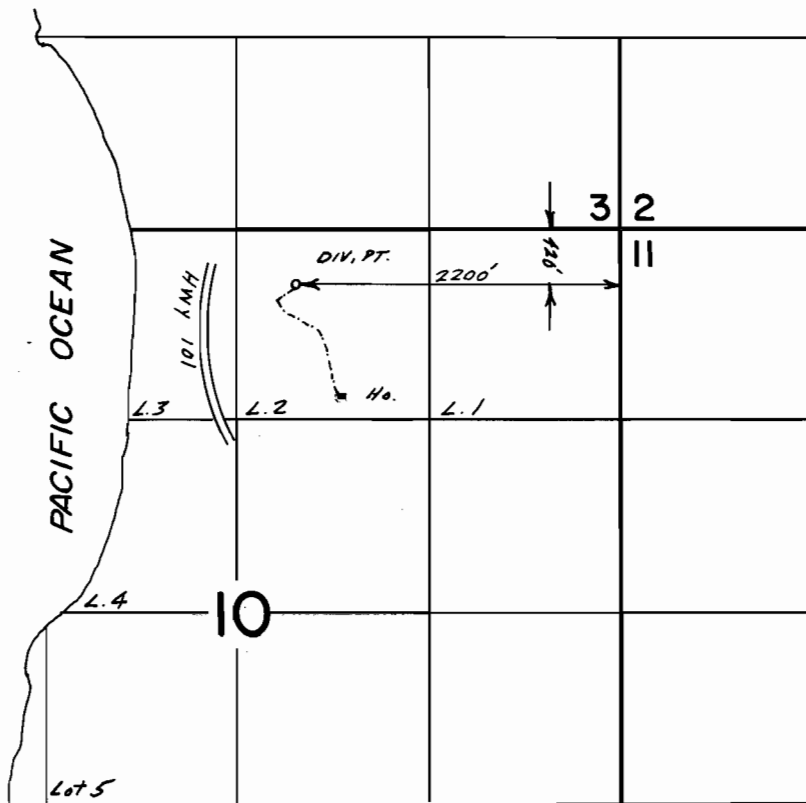

Scale 1"=1320'

FINAL PROOF SURVEY UNDER

Application No. 59874.. Permit No. 45382.....
IN NAME OF

.....
Surveyed June 6, 1990, by B.S. JAMES.....