


T. 6 S., R. 5 W., W.M.

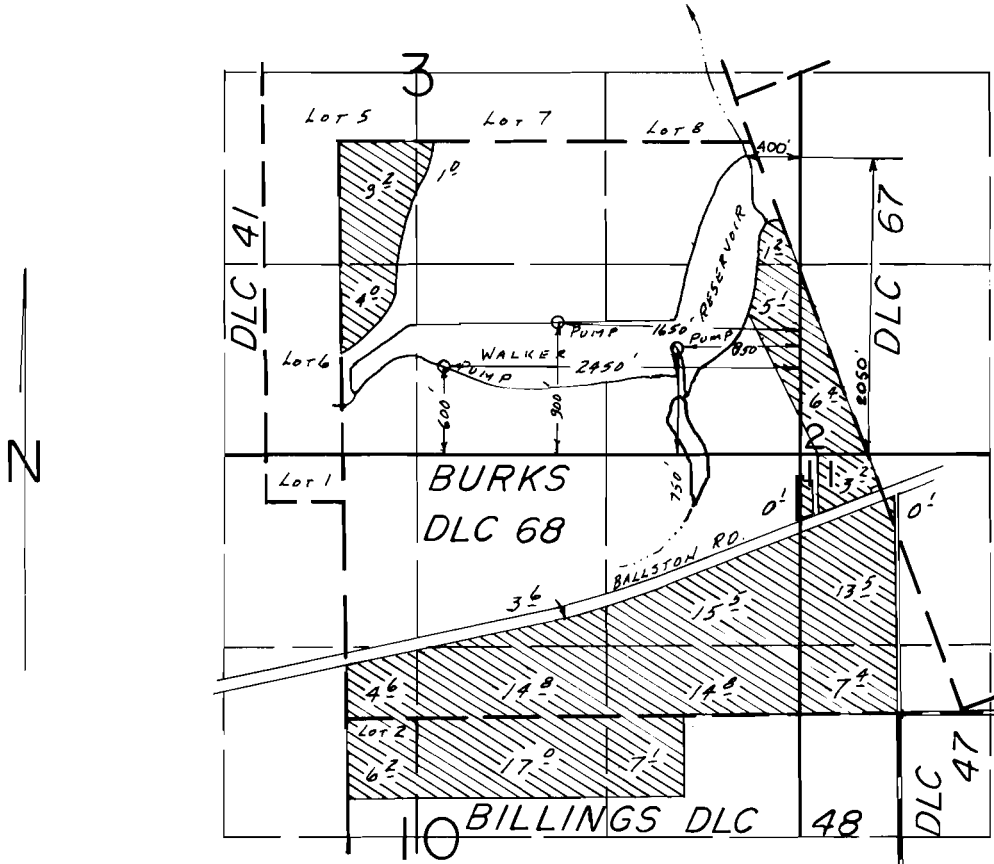

SCALE: 1" = 1320'

FINAL PROOF SURVEY
UNDER

Application No. 60789... Permit No. 45352.....
IN NAME OF

ROBERT T. WALKER

Surveyed April 28 1987, by B.W. BISHOP.....

3/8/89

41053-178-213A

BWB