


T. 22 S., R. 12 W., W.M.

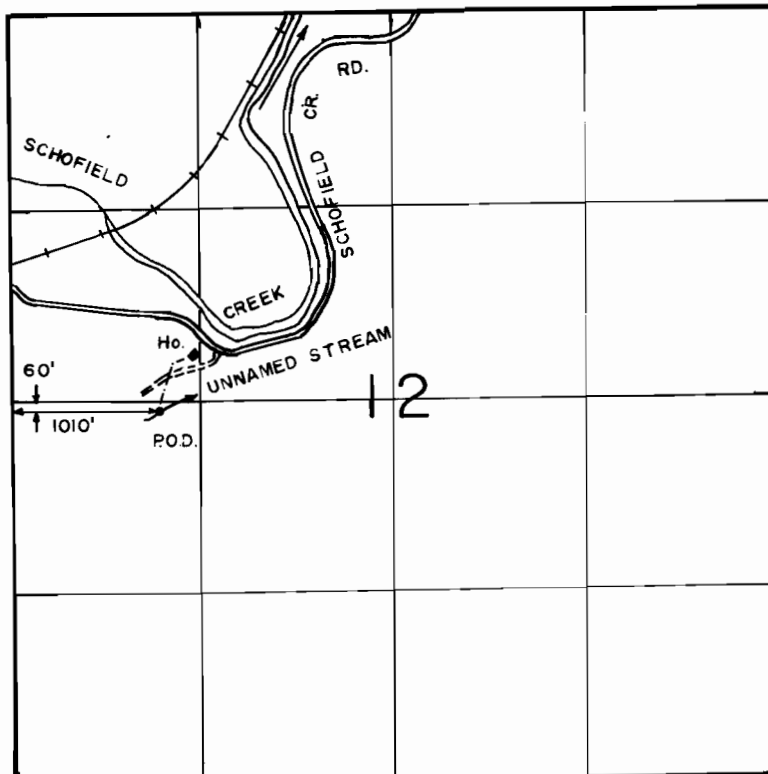

1" = 1320'

FINAL PROOF SURVEY
UNDER

Application No. **61042** Permit No. **45543**
IN NAME OF

WILLIAM SCHNEIDER

Surveyed **SEPT. 25 1990**, by **L.M. JOACHIN**

5-20-91 DSM

41019-178-163L