


T. 12 S., R. 11 W., W.M.

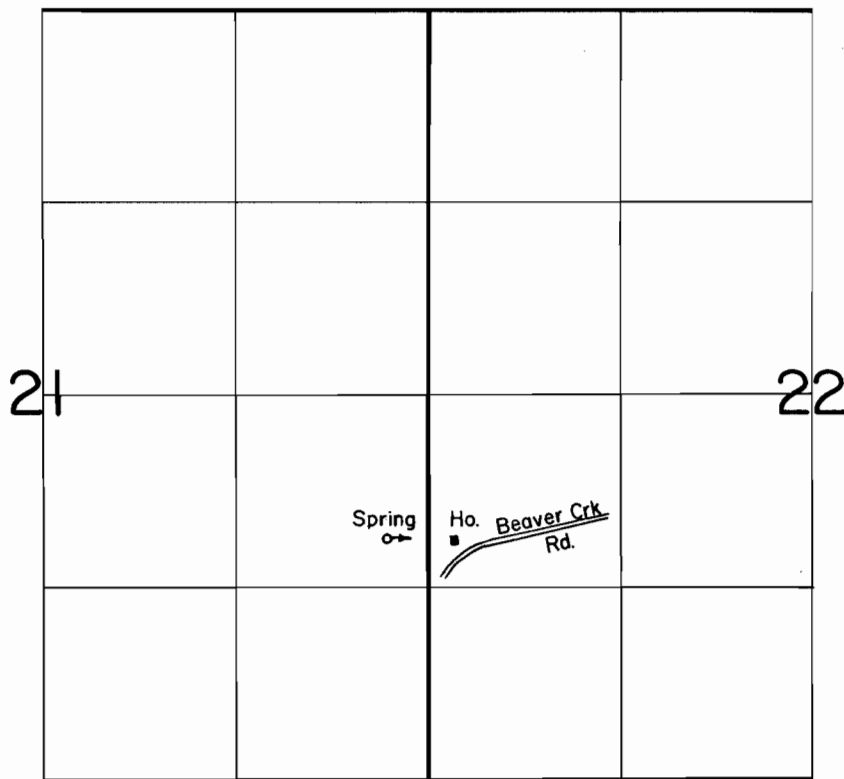

Spring Loc.: 990' S. & 290' W. from W. 1/4 Cor. Sec. 22

Scale : 1" = 1320'

FINAL PROOF SURVEY

UNDER

Application No. 62125..... Permit No. 46354.....
IN NAME OF

.....PILLING.....

Surveyed Sept. 22, 1989, by R. KLASSEN.....